IREDELL COUNTY HEALTH DEPARTMENT

STATESVILLE 704-878-5305 MOORESVILLE 704-664-5281

IMPROVEMENT PERMIT / AUTHORIZATION TO CONSTRUCT / OPERATION PERMIT / EXISTING SYSTEM INSPECTION

PERMIT# 77980 PIN# 4762 51 6439 DATE 6-15-99

OWNER OR CONTRACTOR Freedom Homes PHONE: Business 528 9449 Home

ADDRESS 1018 Charlotte Hwy Troutman N.C.

LOCATION 70 E TR Bethesta Rd TL Hickory Nut TR Breezeway at ent Rt.

SUBDIVISION Laurel Grove BLOCK / SECTION LOT 35 LOT AREA 1.52 acres SITE CLASS PS DESIGN FLOW 480 L.T.A.R. .13

Septic Tank: 1000 Gallons; STB 1017 Date 5-7-99
Pump Tank: Gallons; PT Date
Pump Make: Model 1600 Serial No 533
Nitrification Field: No Fields 1 Square Feet 1200 Linear Feet 400
No Lines 4 Trench Width 36" Max Trench Bottom Depth 36" Gravel Depth 12"

☑ New System ☐ Repair System Type: ☐ I ☐ II ☐ III ☐ IV ☐ V ☐ VI
System Description: Conv. Gravity
Repair System Description:
Maintenance Agreement Required: ☐ Yes ☑ No
☐ Slab ☑ Crawl Space ☐ Basement w/plumbing ☐ Basement wo/plumbing


☑ House/Mod. Home No. Bedrooms 4
☑ Mobile Home No. Bathrooms 2
☐ Business No. Employees
☐ Other

Water Supply: ☑ Individual ☐ Public ☐ Community


Comments/Conditions:

Comments/Conditions:
* Tank shifted to opposite side of house

INITIAL SITE SKETCH

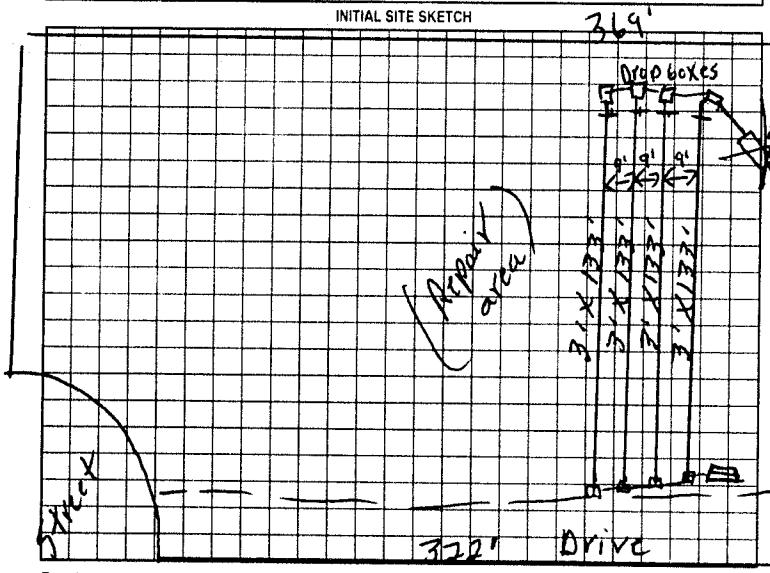

AS BUILT SKETCH

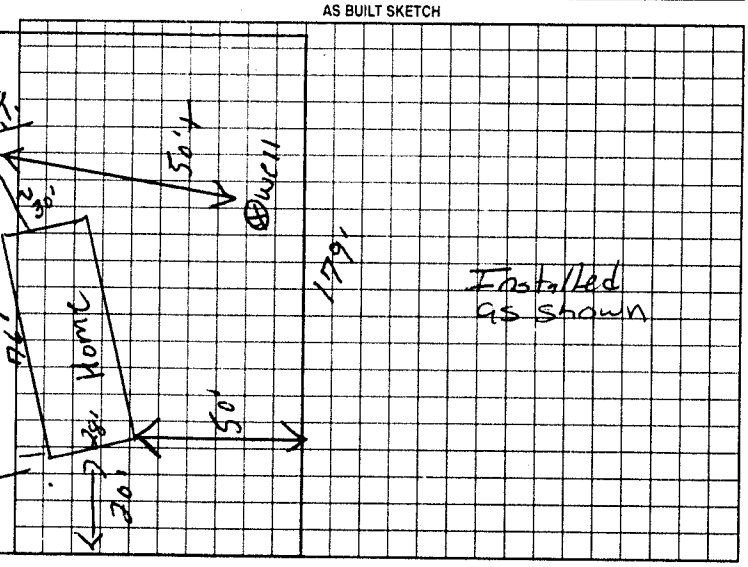

Permit can be suspended or revoked if any false information is supplied toward securing the permit/any unauthorized changes are made to the site/any unauthorized changes are made in the installation of the system. Improvement Permit with plat valid without expiration; Improvement Permit with site plan valid for sixty months. Authorization to Construct is valid for a period equal to that of Improvement Permit -- not to exceed sixty months.

Signed: date 6/15/99 Installed by: A-1

Improvement Permit by: R. C. Moore date 6-15-99 Operation Permit by: Mary Coff 125 date 7-6-99

Authorization to Construct by: R. C. Moore date 6-15-99 Existing System Inspection by: date

HEALTH DEPT COPY: WHITE OWNER COPY (FINAL) YELLOW OWNER COPY (INITIAL) PINK