IREDELL COUNTY HEALTH DEPARTMENT

STATESVILLE 704-878-5305 MOORESVILLE 704-664-5281

IMPROVEMENT PERMIT / AUTHORIZATION TO CONSTRUCT / OPERATION PERMIT / EXISTING SYSTEM INSPECTION

PERMIT# 81609 PIN# 4762517699 DATE 6-4-99

OWNER OR CONTRACTOR Maonica Klonoski PHONE: Business Home 662 0124

ADDRESS 900 west wilson Ave mooresville, N.C.

LOCATION 70 E TR Bethesda TL Hickory Nut TR Breezeway on Rt

SUBDIVISION Laurel Grove BLOCK / SECTION LOT 37 LOT AREA 1.0 acre SITE CLASS PS DESIGN FLOW 480 L.T.A.R. .3

Septic Tank: 1000 Gallons; STB 1012 Date 6 14 99
Pump Tank: Gallons; PT Date
Pump Make: Model Serial No.
Nitrification Field: No Fields 1 Square Feet 1200 Linear Feet 400
No Lines 4 Trench Width 36" Max Trench Bottom Depth 36" Gravel Depth N/A

☐ New System ☐ Repair System Type: I. II. III. IV. V. VI
System Description: Gravity 25% Reduction
Repair System Description:
Maintenance Agreement Required: Yes No

☐ House/Mod. Home ☐ Mobile Home ☐ Business ☐ Other
No. Bedrooms 4 No. Bathrooms 2 No. Employees


☐ Slab ☐ Crawl Space ☐ Basement w/plumbing ☐ Basement wo/plumbing

Water Supply: ☐ Individual ☐ Public ☐ Community


Comments/Conditions:

Comments/Conditions

INITIAL SITE SKETCH

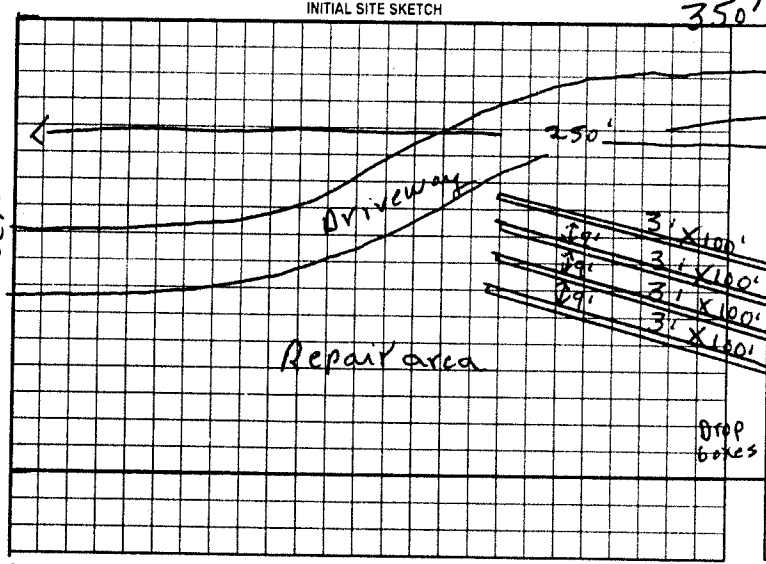

AS BUILT SKETCH

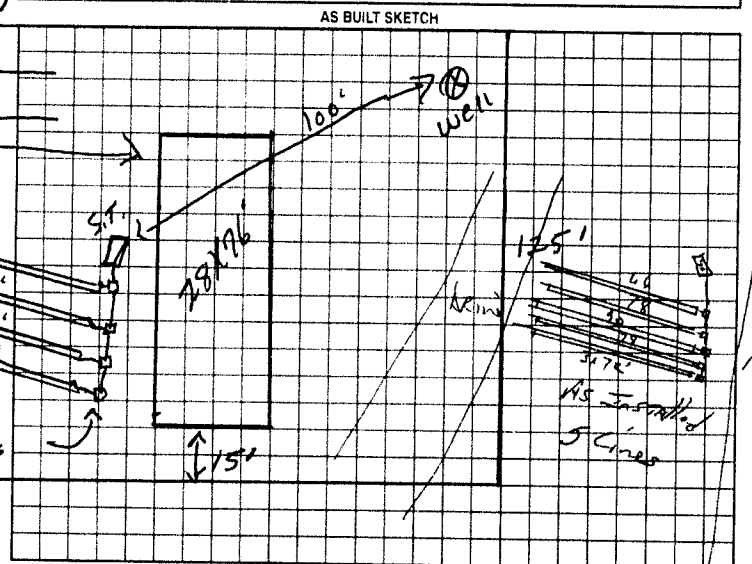

Permit can be suspended or revoked if any false information is supplied toward securing the permit/any unauthorized changes are made to the site/any unauthorized changes are made in the installation of the system. Improvement Permit with plat valid without expiration. Improvement Permit with site plan valid for sixty months. Authorization to Construct is valid for a period equal to that of Improvement Permit – not to exceed sixty months.

Signed: date 6-9-99 Installed by: A1 Backhoe

Improvement Permit by: R.C. Moore date 6-4-99 Operation Permit by: date May 18 99

Authorization to Construct by: R.C. Moore date 6-4-99 Existing System Inspection by: date

HEALTH DEPT COPY WHITE OWNER COPY (FINAL) YELLOW OWNER COPY (INITIAL) PINK