IREDELL COUNTY HEALTH DEPARTMENT

STATESVILLE 704-878-5305 MOORESVILLE 704-664-5281 (C1)

IMPROVEMENT PERMIT / AUTHORIZATION TO CONSTRUCT / OPERATION PERMIT / EXISTING SYSTEM INSPECTION

PERMIT# 111177 PIN# 4762-51-7893 DATE 2-26-03

OWNER OR CONTRACTOR STALLINGS HOME INC PHONE: Business 704-933-9722 Home

ADDRESS 200 N. CANNON BLVD KANNAPOLIS NC 28083

LOCATION US 70 EAST, TR BETHESDA ROAD, TL HICKORY NUT DRIVE, TR BREEZEWAY LANE 7TH LOT ON RIGHT

SUBDIVISION LAUREL GROVE BLOCK / SECTION LOT 38 LOT AREA 1 ACRE SITE CLASS PS DESIGN FLOW 360 L.T.A.R. 0.30 GPD/FT²

Septic Tank: 1000 Gallons; STB Date

Pump Tank: Gallons; PT Date

Pump Make: Model Serial No.

Nitrification Field: No Fields 1 Square Feet 1200 Linear Feet 400

No Lines THREE Trench Width 36" Max Trench Bottom Depth 36" Gravel Depth 12"

☐ New System ☐ Repair System Type: I (II) III. IV. V. VI

System Description: CONVENTIONAL, GRAVITY

Repair System Description: CONVENTIONAL, GRAVITY

Maintenance Agreement Required: ☐ Yes ☑ No

☐ House/Mod. Home ☑ Mobile Home ☐ Business ☐ Other

No. Bedrooms 3 No. Bathrooms 2 No. Employees


☐ Slab ☑ Crawl Space ☐ Basement w/plumbing ☐ Basement wo/plumbing

Water Supply: ☑ Individual ☐ Public ☐ Community WELL


Comments:/Conditions:

Comments:/Conditions: KEEP BUILDING FOUNDATION MINIMUM FIVE (5) FEET FROM SYSTEM

INITIAL SITE SKETCH

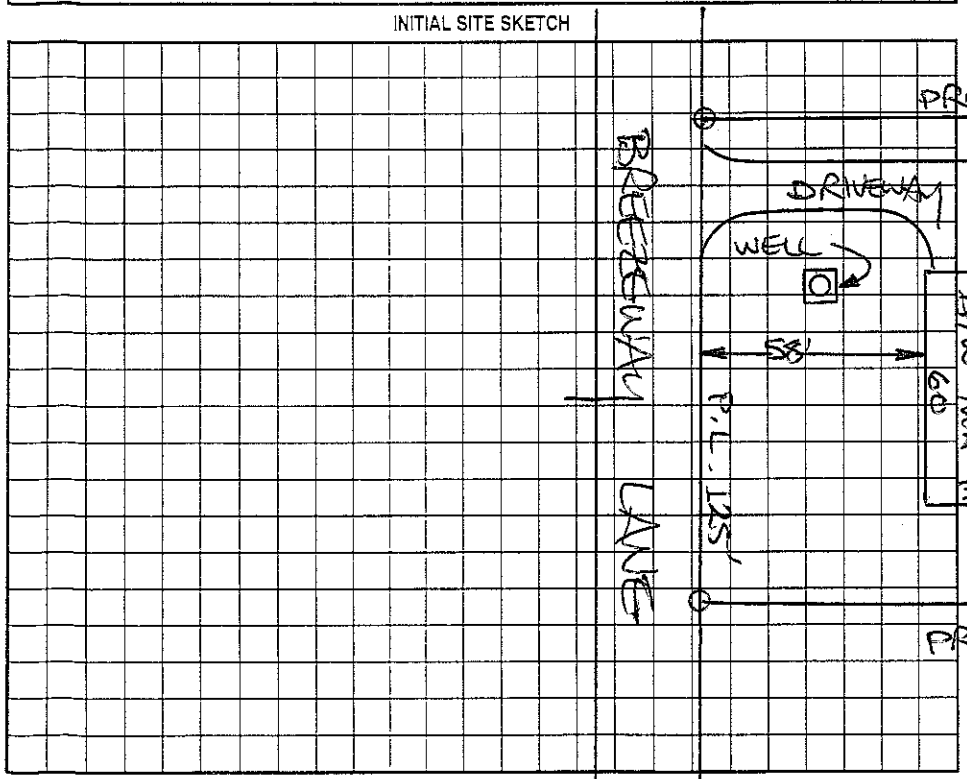

AS BUILT SKETCH

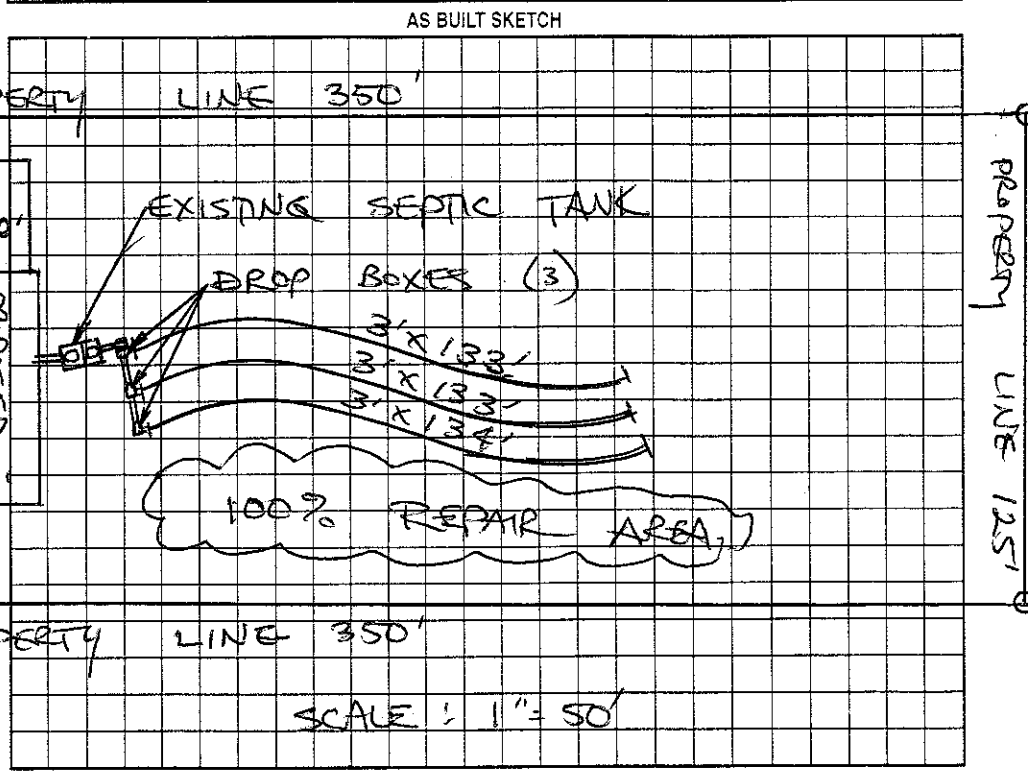

Permit can be suspended or revoked if any false information is supplied toward securing the permit/any unauthorized changes are made to the site/any unauthorized changes are made in the installation of the system. Improvement Permit with plat valid without expiration. Improvement Permit with site plan valid for sixty months. Authorization to Construct is valid for a period equal to that of Improvement Permit – not to exceed sixty months.

Signed: date Installed by:

Improvement Permit by: date Operation Permit by: date

Authorization to Construct by: date Existing System Inspection by: STEVE HOPPICK date 2-26-03

HEALTH DEPT. COPY: WHITE OWNER COPY (FINAL): YELLOW OWNER COPY (INITIAL): PINK