IREDELL COUNTY HEALTH DEPARTMENT

STATESVILLE 704-878-5305 MOORESVILLE 704-664-5281

IMPROVEMENT PERMIT / AUTHORIZATION TO CONSTRUCT / OPERATION PERMIT / EXISTING SYSTEM INSPECTION

PERMIT# 12931 PIN# 4762514404 21404 DATE 1-21-05

OWNER OR CONTRACTOR Jeff Roberson PHONE: Business 704-309-0471 Home

ADDRESS 702 E Bethesda Rd Hickory NC 10th lot on right Laural Grove Sub.

LOCATION

SUBDIVISION Laurel Grove BLOCK / SECTION LOT 49 LOT AREA 1.36 Ac SITE CLASS. R5 DESIGN FLOW 360 L.T.A.R. .33

Laurel Grove

Septic Tank: 1000 Gallons; STB 1794 Date 10-3-99

Pump Tank: Gallons; PT Date

Pump Make: Model Serial No.

Nitrification Field: No Fields Square Feet 1080 Linear Feet 360

No Lines 6 Trench Width 36" Max Trench Bottom Depth 36" Gravel Depth 12

☐ New System ☐ Repair System Type: I, II, III, IV, V, VI

System Description: Coventional Gravity

Repair System Description:

Maintenance Agreement Required: ☐ Yes ☐ No

☑ House/Mod. Home No. Bedrooms 3

☐ Mobile Home No. Bathrooms 2

☐ Business No. Employees

☐ Other

☐ Slab ☐ Crawl Space ☐ Basement w/plumbing ☐ Basement wo/plumbing

Water Supply: ☑ Individual ☐ Public ☐ Community


Comments:/Conditions:

Comments:/Conditions:

seen House Plans

INITIAL SITE SKETCH

AS BUILT SKETCH

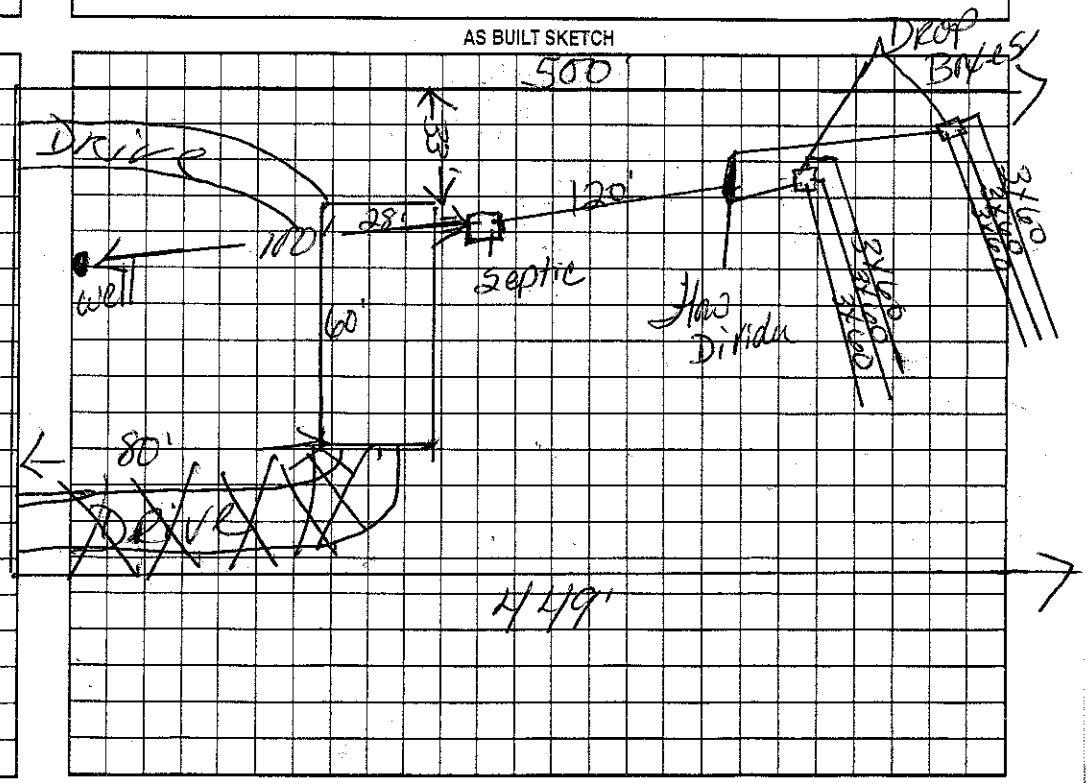

Permit can be suspended or revoked if any false information is supplied toward securing the permit/any unauthorized changes are made to the site/any unauthorized changes are made in the installation of the system. Improvement Permit with plat valid without expiration. Improvement Permit with site plan valid for sixty months. Authorization to Construct is valid for a period equal to that of Improvement Permit – not to exceed sixty months.

Signed: date Installed by:

Improvement Permit by: date Operation Permit by: date

Authorization to Construct by: date Existing System Inspection by: date 7-21-05

HEALTH DEPT. COPY: WHITE OWNER COPY (FINAL): YELLOW OWNER COPY (INITIAL): PINK