IREDELL COUNTY HEALTH DEPARTMENT

STATESVILLE 704-878-5305 MOORESVILLE 704-664-5281

IMPROVEMENT PERMIT / AUTHORIZATION TO CONSTRUCT / OPERATION PERMIT / EXISTING SYSTEM INSPECTION

PERMIT# 82255 PIN# 4762521880 DATE 7-9-99

OWNER OR CONTRACTOR American Land PHONE: Business 878 9595 Home

ADDRESS 1281 Garner Bagnal Blvd Statesville

LOCATION 70E TR Bethesta TL Hickory Nut 1/4 mi left.

SUBDIVISION Laural Grove BLOCK / SECTION LOT 10 LOT AREA 1.070 acres SITE CLASS 05 DESIGN FLOW 360 L.T.A.R. .3

Septic Tank: 1000 Gallons; STB 102 Date 5-14-99
Pump Tank: Gallons; PT Date
Pump Make: Model Serial No.
Nitrification Field: No Fields 1 Square Feet 1200 Linear Feet 400
No Lines 3 Trench Width 36" Max Trench Bottom Depth 36" Gravel Depth 12"

☐ New System ☐ Repair System Type: I (II) III, IV, V, VI
System Description: Conv. Gravity
Repair System Description:
Maintenance Agreement Required: ☐ Yes ☒ No


☐ House/Mod. Home No. Bedrooms 3
☐ Mobile Home No. Bathrooms 2
☐ Business No. Employees
☐ Other
☐ Slab ☒ Crawl Space ☐ Basement w/plumbing ☐ Basement wo/plumbing

Water Supply: ☒ Individual ☐ Public ☐ Community


Comments/Conditions:

Comments/Conditions: Installed as shown

INITIAL SITE SKETCH

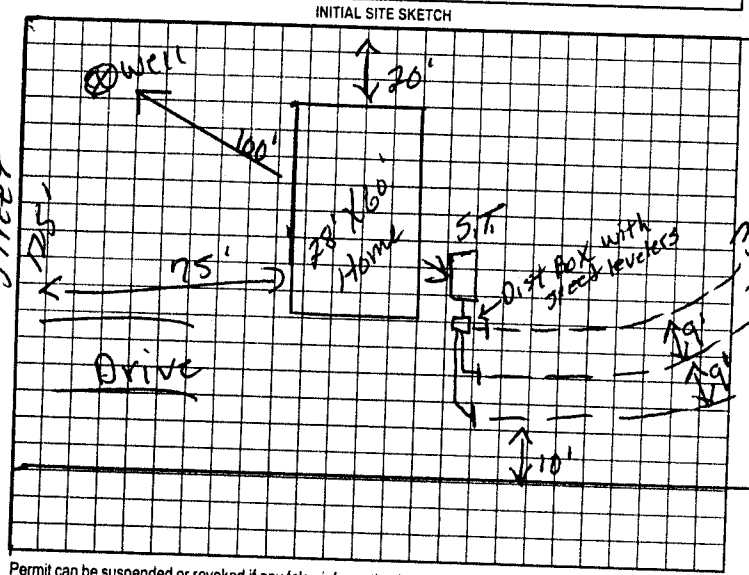

AS BUILT SKETCH

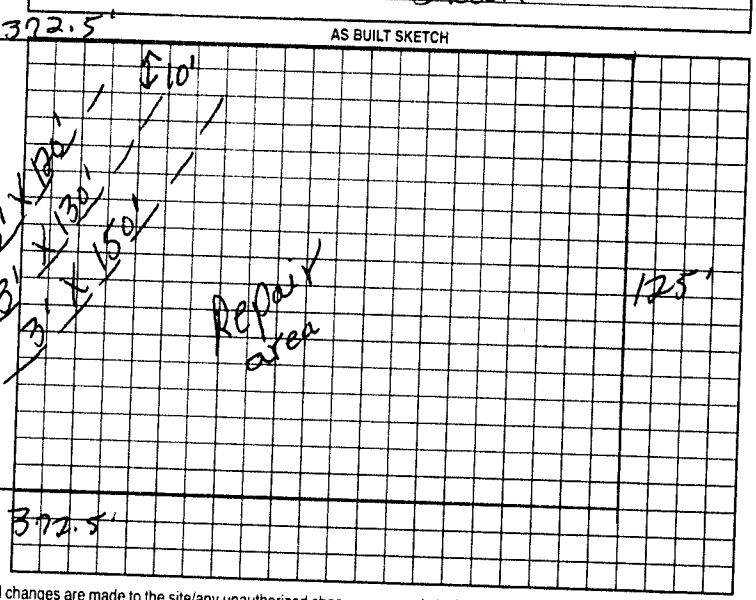

Permit can be suspended or revoked if any false information is supplied toward securing the permit/any unauthorized changes are made to the site/any unauthorized changes are made in the installation of the system. Improvement Permit with plat valid without expiration. Improvement Permit with site plan valid for sixty months. Authorization to Construct is valid for a period equal to that of Improvement Permit – not to exceed sixty months.

Signed: [signature] date 7-13-99 Installed by: A-1 Backhoe

Improvement Permit by: P. C. Moore date 7-9-99 Operation Permit by: Mat Cuthbertson date 7-16-99

Authorization to Construct by: P. C. Moore date 7-9-99 Existing System Inspection by: date

HEALTH DEPT. COPY: WHITE OWNER COPY (FINAL) YELLOW OWNER COPY (INITIAL) PINK