THIS PERMIT VOIDS PREVIOUS ISSUED 1-3-00

IREDELL COUNTY HEALTH DEPARTMENT

STATESVILLE 704-878-5305 MOORESVILLE 704-664-5281

IMPROVEMENT PERMIT / AUTHORIZATION TO CONSTRUCT / OPERATION PERMIT / EXISTING SYSTEM INSPECTION

PERMIT# 87248 PIN# 4762 52 3447 DATE 1-24-01

OWNER OR CONTRACTOR BRANDON WADE PHONE: Business Home (704) 682-1261

ADDRESS 161 HENDERSON STATESVILLE, NC 28677

LOCATION US 70 E, TR BETHESDA RD, TL HICKORY NUT DR, 12TH LOT ON RIGHT

SUBDIVISION LAUREL GROVE BLOCK / SECTION I LOT A7 LOT AREA 1.56 ACRES SITE CLASS PS DESIGN FLOW 360 L.T.A.R. 0.33 GPD/FT²

Septic Tank: 1000 Gallons: STB 825 Date 10-5-00
Pump Tank: Gallons: PT Date
Pump Make: Model Serial No.
Nitrification Field: No Fields 1 Square Feet 1080 Linear Feet 360
No Lines FOUR Trench Width 36" Max Trench Bottom Depth 36" Gravel Depth 12"

☑ New System ☐ Repair System Type: I (II) III IV V VI
System Description: CONVENTIONAL GRAVITY
Repair System Description: CONV. GRAVITY
Maintenance Agreement Required: ☐ Yes ☑ No

☐ House/Mod. Home ☑ Mobile Home ☐ Business ☐ Other
No. Bedrooms 3 No. Bathrooms 2 No. Employees


☐ Slab ☑ Crawl Space ☐ Basement w/plumbing ☐ Basement wo/plumbing

Water Supply: ☑ Individual ☐ Public ☐ Community WELL


Comments/Conditions: KEEP SYSTEM MINIMUM 100 FEET FROM WELL

Comments/Conditions: SYSTEM INSTALLED AS SHOWN WITH POLYLOK FILTER & MARKER

INITIAL SITE SKETCH SCALE: 1" = 40'

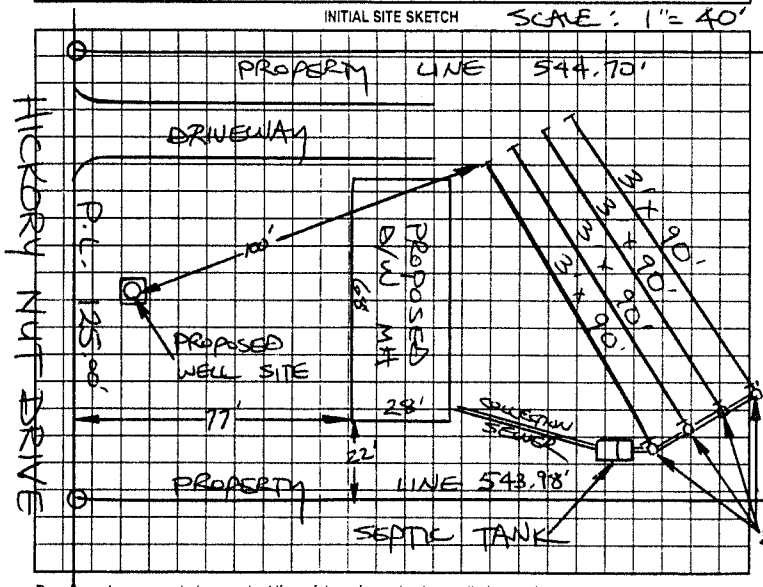

AS BUILT SKETCH

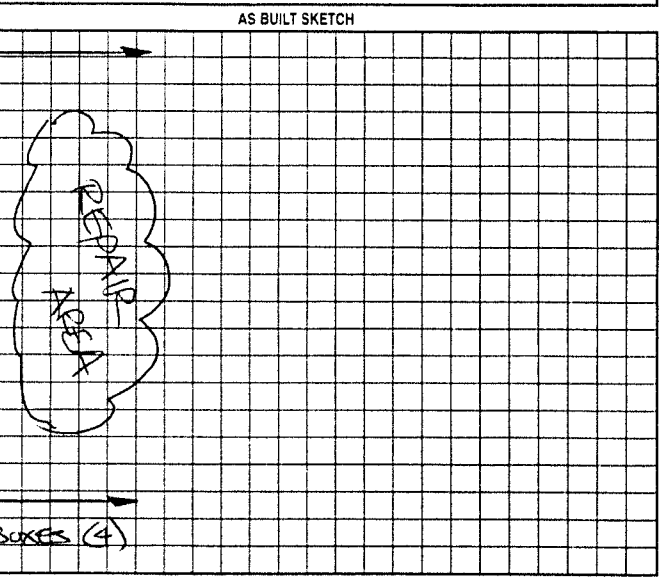

Permit can be suspended or revoked if any false information is supplied toward securing the permit/any unauthorized changes are made to the site/any unauthorized changes are made in the installation of the system. Improvement Permit with plat valid without expiration. Improvement Permit with site plan valid for sixty months. Authorization to Construct is valid for a period equal to that of Improvement Permit – not to exceed sixty months.

Signed: Brandon Wade date 1-24-01

Improvement Permit by: STEVE HEDRICK date 1-24-01

Authorization to Construct by: STEVE HEDRICK date 1-24-01

Installed by: ROWAN SEPTIC

Operation Permit by: Steve Cook REHS date 02-27-01

Existing System Inspection by: date

HEALTH DEPT COPY WHITE OWNER COPY (FINAL) YELLOW OWNER COPY (INITIAL) PINK