IREDELL COUNTY HEALTH DEPARTMENT

STATESVILLE 704-878-5305 MOORESVILLE 704-664-5281

IMPROVEMENT PERMIT / AUTHORIZATION TO CONSTRUCT / OPERATION PERMIT / EXISTING SYSTEM INSPECTION

PERMIT# 87516 PIN# 4762 52 4478 DATE 1-27-00

OWNER OR CONTRACTOR American Land Corp PHONE: Business 878 9595 Home

ADDRESS 1281 Garner Bagnal Blvd Statesville

LOCATION 70 E TR Bethesta Rd TL Hickory Nut on Rt

SUBDIVISION Laural Grove BLOCK / SECTION LOT 46 LOT AREA 1 1/2 acres SITE CLASS PS DESIGN FLOW 480 L.T.A.R. .33

Septic Tank: 1000 Gallons; STB [redacted] Date 11-15-99

Pump Tank: Gallons; PT 1012 Date

Pump Make: Model Serial No.

Nitrification Field: No Fields 1 Square Feet 1440 Linear Feet 480

No Lines 5 Trench Width 36" Max Trench Bottom Depth 36" Gravel Depth 12"

☑ New System ☐ Repair System Type: I, (II), III, IV, V, VI

System Description: Conv. Gravity

Repair System Description: " "

Maintenance Agreement Required: ☐ Yes ☑ No

☐ Slab ☑ Crawl Space ☐ Basement w/plumbing ☐ Basement wo/plumbing

☐ House/Mod. Home ☑ Mobile Home ☐ Business ☐ Other


No. Bedrooms 4 No. Bathrooms 2 No. Employees

Water Supply: ☑ Individual ☐ Public ☐ Community


Comments:/Conditions:

Comments:/Conditions: Same as initial sketch

INITIAL SITE SKETCH

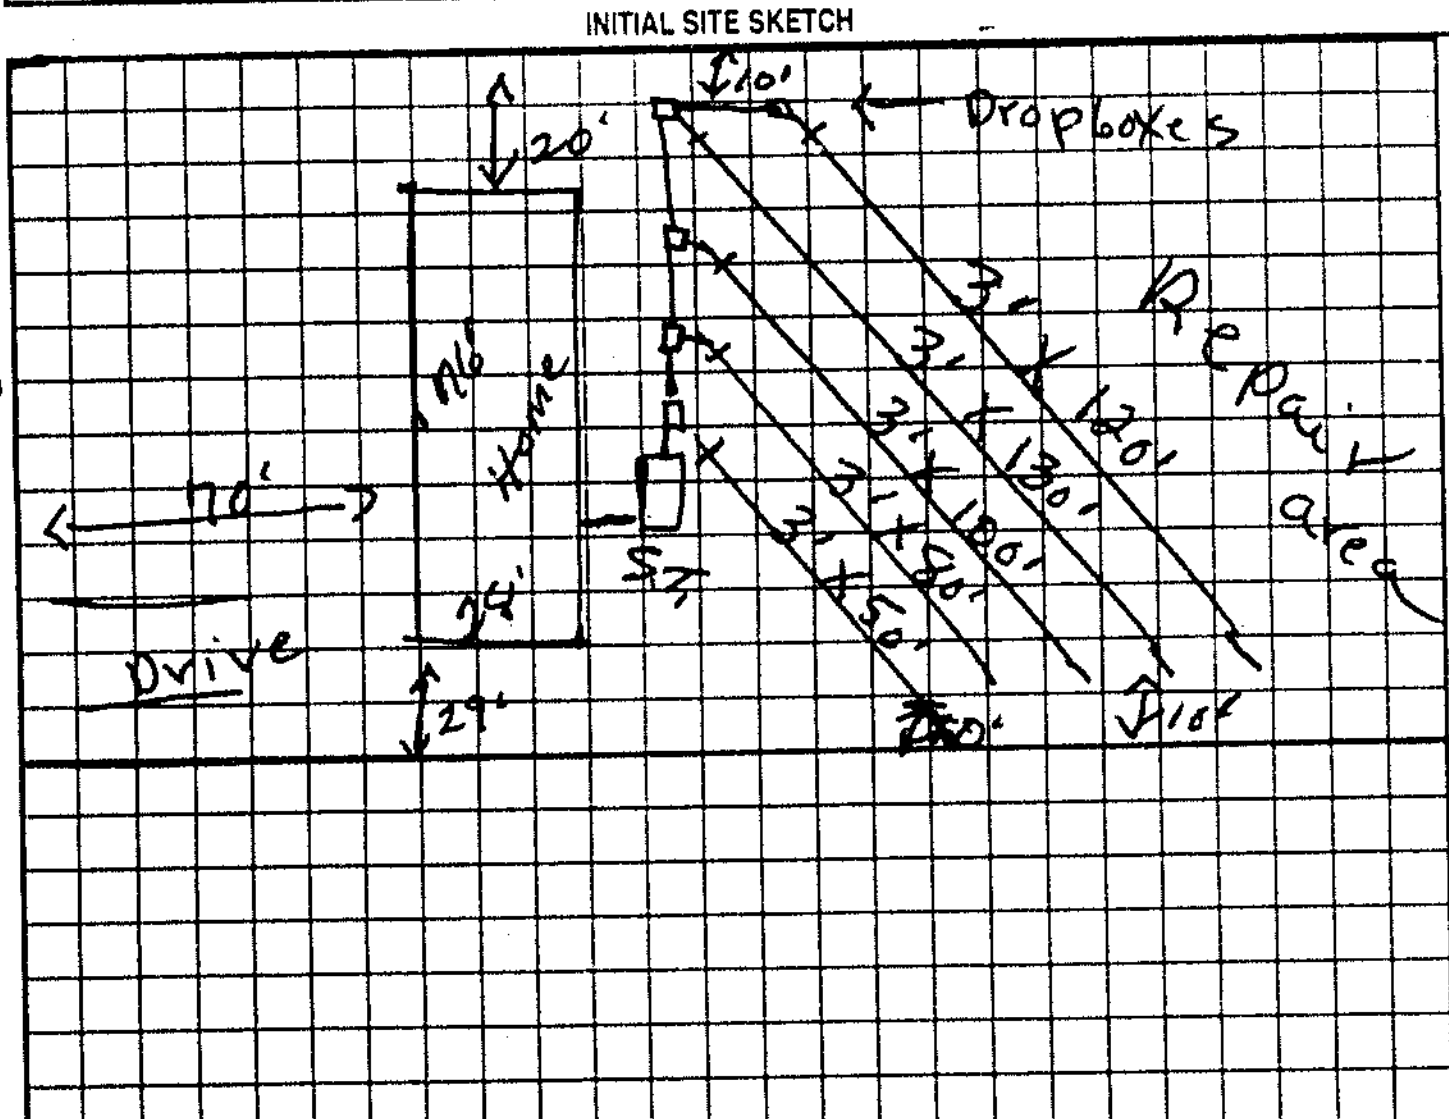

AS BUILT SKETCH

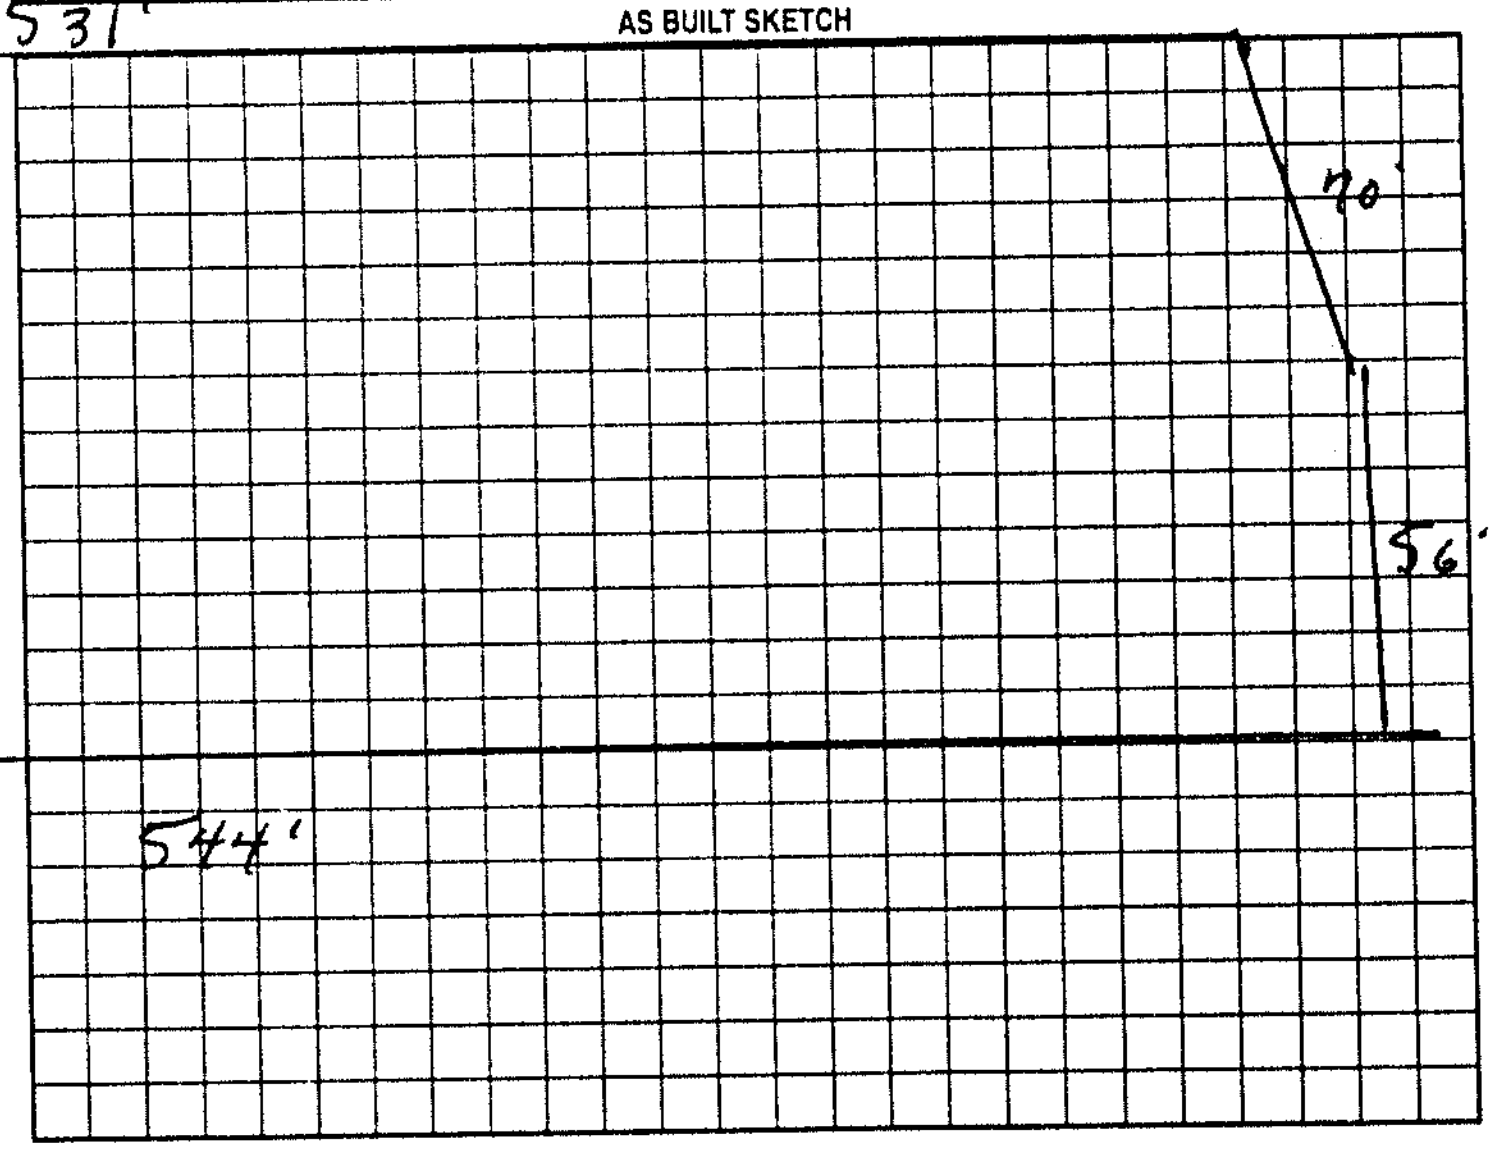

Permit can be suspended or revoked if any false information is supplied toward securing the permit/any unauthorized changes are made to the site/any unauthorized changes are made in the installation of the system. Improvement Permit with plat valid without expiration. Improvement Permit with site plan valid for sixty months. Authorization to Construct is valid for a period equal to that of Improvement Permit – not to exceed sixty months.

Signed: [signature] date 1-28-00 Installed by: A-1 Backhoe

Improvement Permit by: L. C. Moore date 1-27-00 Operation Permit by: L. C. Moore date 2-3-00

Authorization to Construct by: L. C. Moore date 1-27-00 Existing System Inspection by: date

HEALTH DEPT. COPY WHITE OWNER COPY (FINAL) YELLOW OWNER COPY (INITIAL) PINK