IREDELL COUNTY HEALTH DEPARTMENT

STATESVILLE 704-878-5305 MOORESVILLE 704-664-5281

IMPROVEMENT PERMIT / AUTHORIZATION TO CONSTRUCT / OPERATION PERMIT / EXISTING SYSTEM INSPECTION

PERMIT# 78997 PIN# 4762516439 DATE 1-27-99

OWNER OR CONTRACTOR Shavi Hoover PHONE: Business 408 7600 Home

ADDRESS 115 E 24th St. Charlotte N.C.

LOCATION 70 E IR Bethesda TL Hickory Nut 12th lot on left

SUBDIVISION Laurel Grove BLOCK / SECTION LOT 12 LOT AREA 1.09 SITE CLASS PS DESIGN FLOW 360 L.T.A.R. .3

Septic Tank: 1000 Gallons; STB 1012 Date 11 3 98
Pump Tank: Gallons; PT Date
Pump Make: Model Serial No.
Nitrification Field: No Fields 1 Square Feet 1200 Linear Feet 400
No Lines 4 Trench Width 36" Max Trench Bottom Depth 36" Gravel Depth 12"

✓ New System Repair System Type: I, II, III, IV, V, VI
System Description: conv. Gravity
Repair System Description: " "
Maintenance Agreement Required Yes ✓ No


✓ House/Mod. Home No. Bedrooms 3
✓ Mobile Home No. Bathrooms 2
Business No. Employees
Other
Slab ✓ Crawl Space Basement w/plumbing Basement wo/plumbing

✓ Water Supply: ✓ Individual Public Community


Comments/Conditions:

Comments/Conditions: If S/T Lids No covered Site shall be MARKed

INITIAL SITE SKETCH

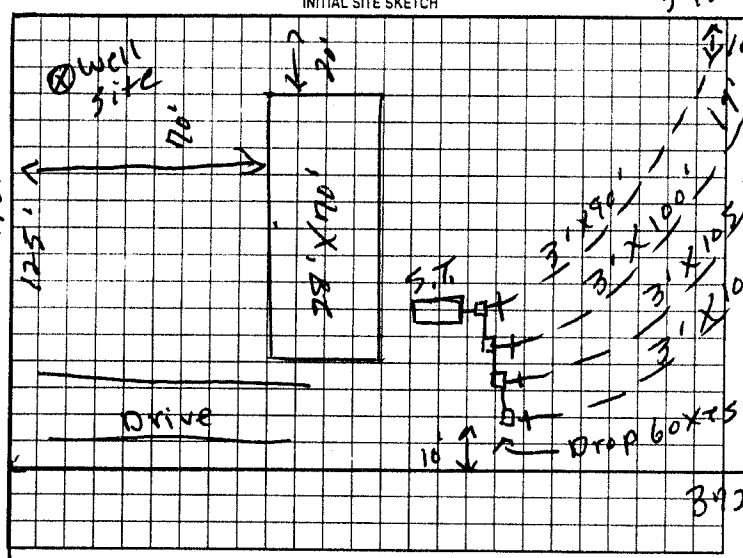

AS BUILT SKETCH

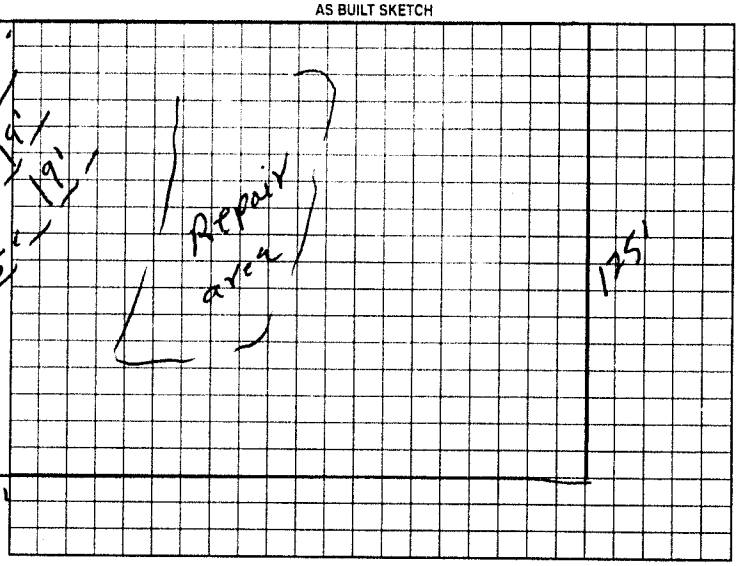

Permit can be suspended or revoked if any false information is supplied toward securing the permit/any unauthorized changes are made to the site/any unauthorized changes are made in the installation of the system. Improvement Permit with plat valid without expiration. Improvement Permit with site plan valid for sixty months. Authorization to Construct is valid for a period equal to that of Improvement Permit – not to exceed sixty months.

Signed: Claudette Ballard date 1-29-99 Installed by: A-1 Backhoe

Improvement Permit by: R. C. Moore date 1-27-99 Operation Permit by: R. C. Moore date 2-5-99

Authorization to Construct by: R. C. Moore date 1-27-99 Existing System Inspection by: date

HEALTH DEPT. COPY WHITE OWNER COPY (FINAL) YELLOW OWNER COPY (INITIAL) PINK