IREDELL COUNTY HEALTH DEPARTMENT

STATESVILLE 704-878-5305 MOORESVILLE 704-664-5281

IMPROVEMENT PERMIT / AUTHORIZATION TO CONSTRUCT / OPERATION PERMIT / EXISTING SYSTEM INSPECTION

PERMIT# 77976 PIN# 4762516439 DATE 2-12-99

OWNER OR CONTRACTOR Linda Redfear PHONE: Business _____ Home 704 664 4990

ADDRESS 401 Bell St Mooresville, N.C.

LOCATION 70 East TR Bethesta To Hickory Nut 13th lot on left

SUBDIVISION Laurel Cove BLOCK / SECTION _____ LOT 13 LOT AREA 1.0 Acres SITE CLASS PS DESIGN FLOW 480 L.T.A.R. .3

Septic Tank: 1000 Gallons; STB 1012 Date 2-17-99
Pump Tank: _____ Gallons; PT _____ Date _____
Pump Make: _____ Model _____ Serial No. _____
Nitrification Field: No Fields 1 Square Feet 1600 Linear Feet 533
No Lines 5 Trench Width 36" Max Trench Bottom Depth 36" Gravel Depth 12"

☐ New System ☐ Repair System Type: ☐ I ☐ II ☐ III ☐ IV ☐ V ☐ VI
System Description: Conv. Gravity
Repair System Description: " "
Maintenance Agreement Required: ☐ Yes ☑ No

☐ House/Mod. Home ☑ Mobile Home ☐ Business ☐ Other
No. Bedrooms 4 No. Bathrooms 2 No. Employees _____


Water Supply: ☑ Individual ☐ Public ☐ Community

☐ Slab ☑ Crawl Space ☐ Basement w/plumbing ☐ Basement wo/plumbing


Comments/Conditions: Permit Replaces Permit issued 12-8-98 To American Land.

Comments/Conditions

INITIAL SITE SKETCH

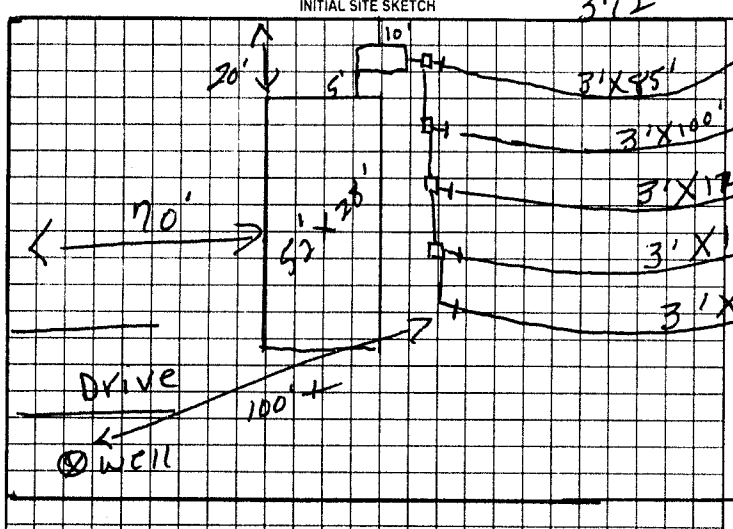

AS BUILT SKETCH

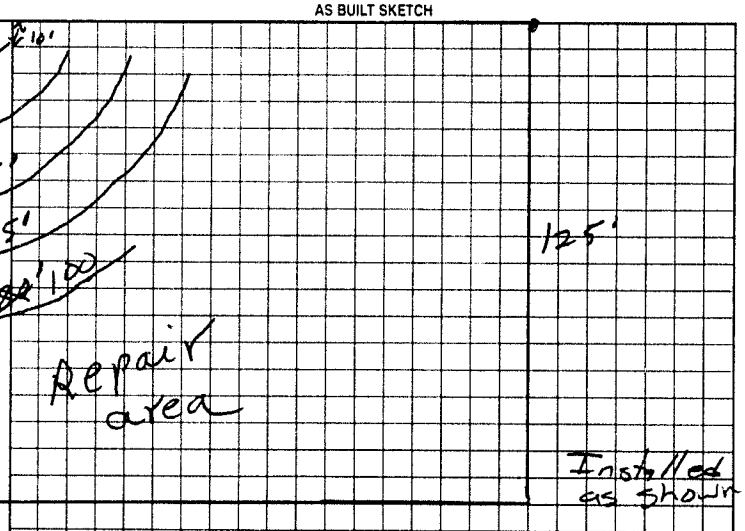

Permit can be suspended or revoked if any false information is supplied toward securing the permit/any unauthorized changes are made to the site/any unauthorized changes are made in the installation of the system. Improvement Permit with plat valid without expiration. Improvement Permit with site plan valid for sixty months. Authorization to Construct is valid for a period equal to that of Improvement Permit -- not to exceed sixty months.

Signed: Linda Redfear date _____ Installed by: A-1 Backhoe

Improvement Permit by: L.C. Moore date 2-12-99 Operation Permit by: Mark C. Ott RS date 4-19-99

Authorization to Construct by: L.C. Moore date 2-12-99 Existing System Inspection by: _____ date _____

HEALTH DEPT COPY WHITE OWNER COPY (FINAL) YELLOW OWNER COPY (INITIAL) PINK