IREDELL COUNTY HEALTH DEPARTMENT

STATESVILLE 704-878-5305 MOORESVILLE 704-664-5281

IMPROVEMENT PERMIT / AUTHORIZATION TO CONSTRUCT / OPERATION PERMIT / EXISTING SYSTEM INSPECTION

PERMIT# 081559 PIN# 4762 52 8356

OWNER OR CONTRACTOR SCOTT McMULLIN DATE 7-27-99

ADDRESS 1310 N. CANNON BLVD. KANNAPOLIS, NC 28083 PHONE: Business Home (704) 933-7200

LOCATION US 70E, TR BETHESDA RD, TL HICKORY NUT, TR BREEZEWAY (MAPLE WOOD), 3RD LOT ON (R)

SUBDIVISION LAUREL GROVE BLOCK / SECTION LOT 41 with 42 LOT AREA 1.09 ACRES + SITE CLASS PS DESIGN FLOW 360 L.T.A.R. 0.25 gpd/ft²

Septic Tank: 1000 Gallons; STB 825 Date 6-17-99
Pump Tank: Gallons; PT Date
Pump Make: Model Serial No.
Nitrification Field: No Fields 1 Square Feet 840 TO 1440 Linear Feet 360+
No Lines THREE Trench Width 36" Max Trench Bottom Depth 36"

☐ New System ☐ Repair System Type: I, II, III, IV, V, VI
System Description: 25% REDUCTION, GRAVITY
Repair System Description: 25% REDUCTION, PUMP
Maintenance Agreement Required: ☐ Yes ☐ No
~~Gravel~~ Depth SAND 6" ☐ Slab ☑ Crawl Space ☐ Basement w/plumbing ☐ Basement wo/plumbing


☐ House/Mod. Home No. Bedrooms 3
☑ Mobile Home No. Bathrooms 2
☐ Business No. Employees
☐ Other

Water Supply: ☑ Individual ☐ Public ☐ Community
WELL


Comments/Conditions: ① KEEP SYSTEM MINIMUM 100 FEET FROM WELL ③ INSTALL SIXTY (60) CHAMBERS OR TWENTY-SIX (36) H.D.S. SECTIONS ON CONTOUR AS FLAGGED

Comments/Conditions

INITIAL SITE SKETCH SCALE: 1"=50'

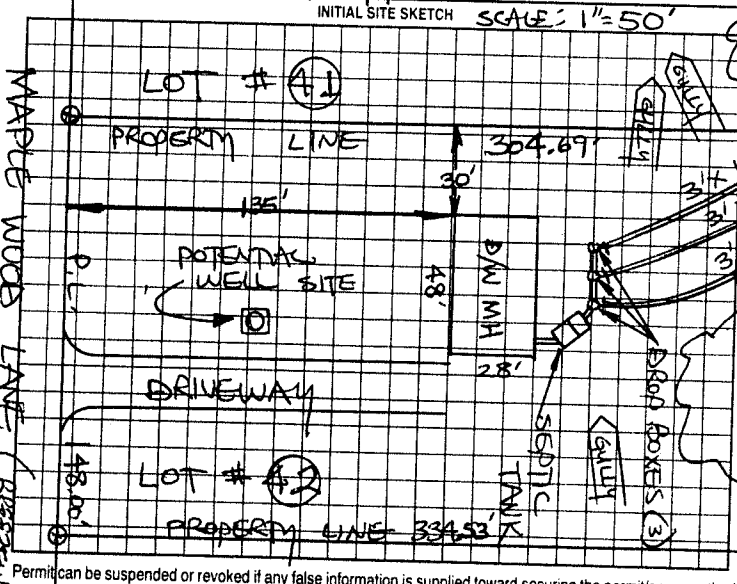

AS BUILT SKETCH

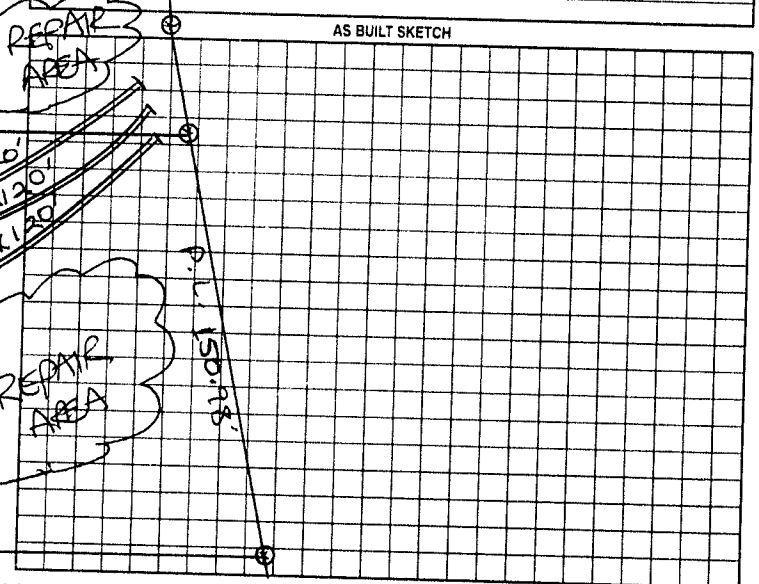

Permit can be suspended or revoked if any false information is supplied toward securing the permit/any unauthorized changes are made to the site/any unauthorized changes are made in the installation of the system. Improvement Permit with plat valid without expiration. Improvement Permit with site plan valid for sixty months. Authorization to Construct is valid for a period equal to that of Improvement Permit – not to exceed sixty months.

Signed: Carl Bradshaw date

Improvement Permit by: STEVE HEARICK date 7-27-99

Authorization to Construct by: STEVE HEARICK date 7-27-99

Installed by: Piedmont Septic

Operation Permit by: [illegible] date 8-17-99

Existing System Inspection by: date

HEALTH DEPT. COPY WHITE OWNER COPY (FINAL) YELLOW OWNER COPY (INITIAL) PINK