IREDELL COUNTY HEALTH DEPARTMENT

STATESVILLE 704-878-5305 MOORESVILLE 704-664-5281

IMPROVEMENT PERMIT / AUTHORIZATION TO CONSTRUCT / OPERATION PERMIT / EXISTING SYSTEM INSPECTION

PERMIT# 81084 PIN# 4762528541 DATE 5-17-99

OWNER OR CONTRACTOR Derek Vanderbusch PHONE: Business Home 704 938 8746

ADDRESS 504 Gopel St. Kannapolis N.C.

LOCATION 70E TR Bethesda TL Hickory Nut TR Breezeway 2nd lot Rt.

SUBDIVISION Laurel Grove BLOCK / SECTION LOT 43 LOT AREA 1.19 acres SITE CLASS PS DESIGN FLOW 360 L.T.A.R. .3

Septic Tank: 1000 Gallons; STB 825 Date 4-2-99
Pump Tank: 1000 Gallons; PT 47 Date 2-8-99
Pump Make: Myers Model ME 40 Serial No.
Nitrification Field: No Fields 1 Square Feet 1200 Linear Feet 400
No Lines 4 Trench Width 36" Max Trench Bottom Depth 36" Gravel Depth 12"

☑ New System ☐ Repair System Type: I, II, III, IV, V, VI
System Description: Pump to Conv.
Repair System Description: " " VI
Maintenance Agreement Required: ☐ Yes ☑ No
☐ Slab ☐ Crawl Space ☐ Basement w/plumbing ☐ Basement wo/plumbing


☑ House/Mod. Home No. Bedrooms 3
☑ Mobile Home No. Bathrooms 2
☐ Business No. Employees
☐ Other

Water Supply: ☑ Individual ☐ Public ☐ Community


Comments/Conditions: See Attached Drawings For Pump Tank & Pressure Manifold Set up 30 gal/min at 20' TDH

Comments/Conditions: Inspected S.T. & P.T. Pressure manifold Drain lines Pump & tit Draw down Test. JCM 5-28-99

INITIAL SITE SKETCH

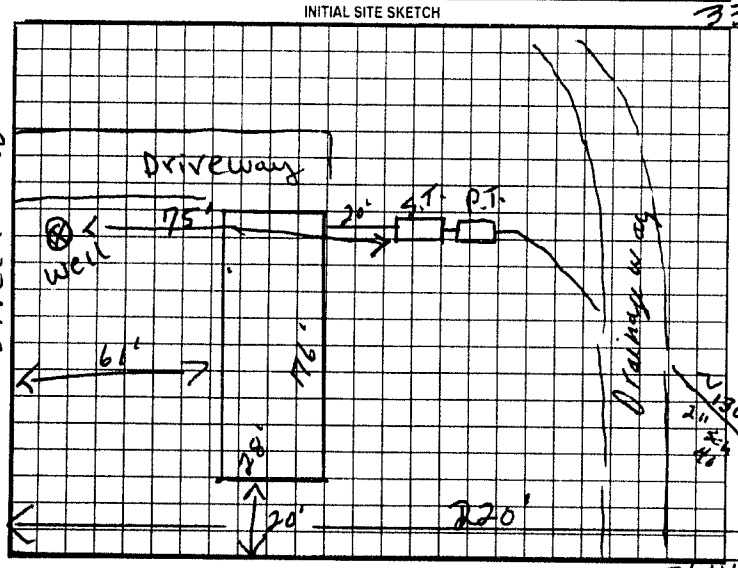

AS BUILT SKETCH

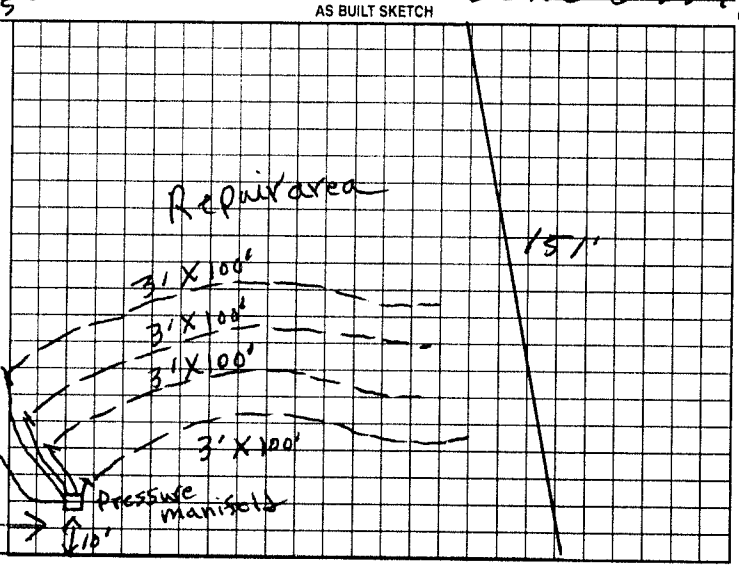

Permit can be suspended or revoked if any false information is supplied toward securing the permit/any unauthorized changes are made to the site/any unauthorized changes are made in the installation of the system. Improvement Permit with plan valid without expiration. Improvement Permit with site plan valid for sixty months. Authorization to Construct is valid for a period equal to that of Improvement Permit – not to exceed sixty months.

Signed: [signature] date 5-18-99 Installed by:

Improvement Permit by: P. C. Moore date 5-17-99 Operation Permit by: [signature] RS date 8-16-99

Authorization to Construct by: P. C. Moore date 5-17-99 Existing System Inspection by: date

HEALTH DEPT COPY WHITE OWNER COPY (FINAL) YELLOW OWNER COPY (INITIAL) PINK