IREDELL COUNTY HEALTH DEPARTMENT

STATESVILLE 704-878-5305 MOORESVILLE 704-664-5281

IMPROVEMENT PERMIT / AUTHORIZATION TO CONSTRUCT / OPERATION PERMIT / EXISTING SYSTEM INSPECTION

PERMIT# 82201 PIN# 4762 52 8644 DATE 7-17-99

OWNER OR CONTRACTOR American Land PHONE: Business 878 9595 Home

ADDRESS 128 Garner Bagnal Blvd.

LOCATION NoE TR Bethania TL Hickory Nut at corner of Breezeway

SUBDIVISION Laurel Grove BLOCK / SECTION LOT 44 LOT AREA .76 acres SITE CLASS PS DESIGN FLOW 360 L.T.A.R. .3

Septic Tank: 1000 Gallons; STB 1160 Date 7-20-99
Pump Tank: Gallons; PT Date
Pump Make: Model Serial No.
Nitrification Field: No Fields 1 Square Feet 1200 Linear Feet 400
No Lines 3 Trench Width 36" Max Trench Bottom Depth 36" Gravel Depth 12"

[ ] New System [ ] Repair System Type: I, II, III, IV, V, VI
System Description: Conv. Gravity
Repair System Description: Pump To Conv.
Maintenance Agreement Required: [ ] Yes [X] No

[ ] Slab [X] Crawl Space [ ] Basement w/plumbing [ ] Basement wo/plumbing


[ ] House/Mod. Home No. Bedrooms 3
[X] Mobile Home No. Bathrooms 2
[ ] Business No. Employees
[ ] Other

Water Supply: [X] Individual [ ] Public [ ] Community


Comments/Conditions:

Comments/Conditions:

INITIAL SITE SKETCH

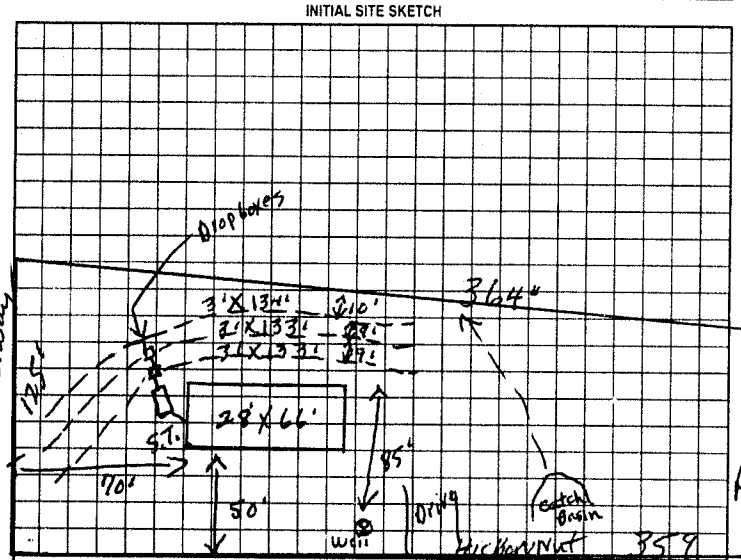

AS BUILT SKETCH

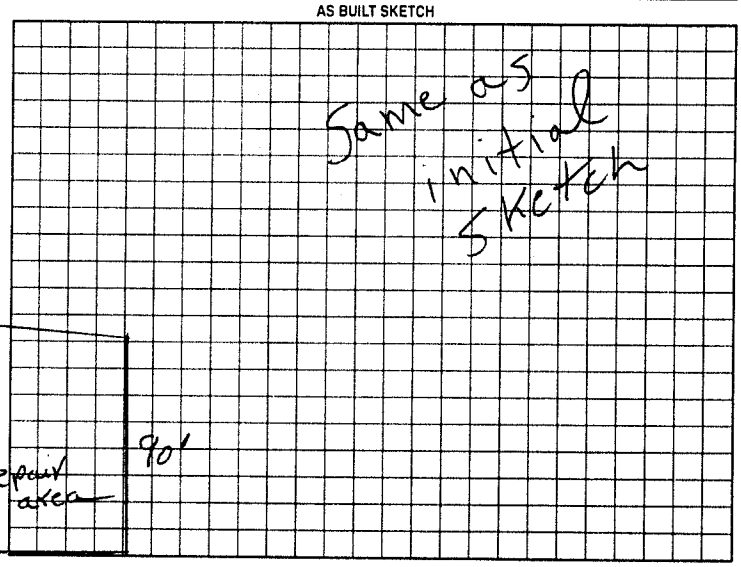

Permit can be suspended or revoked if any false information is supplied toward securing the permit/any unauthorized changes are made to the site/any unauthorized changes are made in the installation of the system. Improvement Permit with plat valid without expiration. Improvement Permit with site plan valid for sixty months. Authorization to Construct is valid for a period equal to that of Improvement Permit -- not to exceed sixty months.

Signed: Sherrie Leslie-Lawson date 7-9-99 Installed by: Upright Grating & Septic

Improvement Permit by: P.C. Moore date 7-7-99 Operation Permit by: P.C. Moore date 11-12-99

Authorization to Construct by: P.C. Moore date 7-7-99 Existing System Inspection by: date

HEALTH DEPT. COPY WHITE OWNER COPY (FINAL) YELLOW OWNER COPY (INITIAL) PINK