IREDELL COUNTY HEALTH DEPARTMENT

STATESVILLE 704-878-5305 MOORESVILLE 704-664-5281

IMPROVEMENT PERMIT / AUTHORIZATION TO CONSTRUCT / OPERATION PERMIT / EXISTING SYSTEM INSPECTION

PERMIT# 79253 PIN# 4762516439 DATE 9-13-99

OWNER OR CONTRACTOR Elfriedi Percy PHONE: Business Home 532 2721

ADDRESS 6225 Dale Ave Charlotte N.C.

LOCATION 70E TR Bethesda TO Hickory Nut on left

SUBDIVISION Laurel Grove BLOCK / SECTION LOT 16 LOT AREA 1.3 acres SITE CLASS PS DESIGN FLOW 480 L.T.A.R. .3

Septic Tank: Ex 1000 Gallons; STB Date

Pump Tank: Gallons; PT Date

Pump Make: Model Serial No.

Nitrification Field: No Fields 1 Square Feet 400 Linear Feet 133

No Lines 1 Trench Width 36" Max Trench Bottom Depth 36" Gravel Depth 12"

☐ New System ☐ Repair System Type: I II III IV V VI

System Description: Gravity Conv.

Repair System Description:

Maintenance Agreement Required: Yes No

☐ House/Mod. Home ☑ Mobile Home ☐ Business ☐ Other

No. Bedrooms 4 No. Bathrooms 2 No. Employees

Water Supply: ☑ Individual ☐ Public ☐ Community

Slab ☑ Crawl Space Basement w/plumbing ☐ Basement wo/plumbing


Comments/Conditions:

Enlarging system To take care of 4BR Home by adding 1- 133' line


Comments/Conditions

Original system To Robert Lawson Added line (3-19-98) To 4BR

INITIAL SITE SKETCH

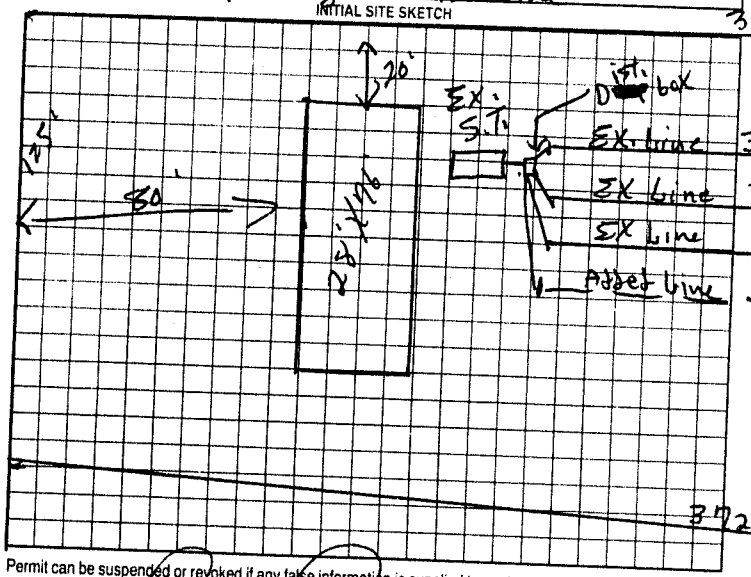

AS BUILT SKETCH

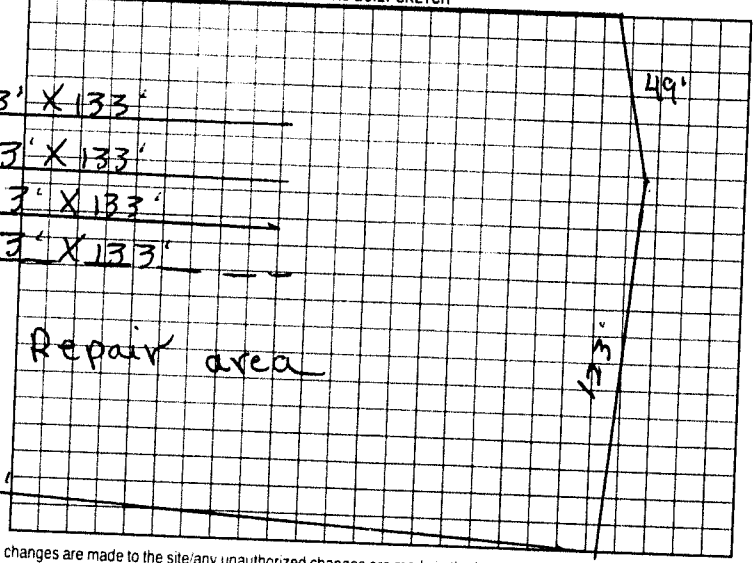

Permit can be suspended or revoked if any false information is supplied toward securing the permit/any unauthorized changes are made to the site/any unauthorized changes are made in the installation of the system. Improvement Permit with plat valid without expiration. Improvement Permit with site plan valid for sixty months. Authorization to Construct is valid for a period equal to that of Improvement Permit -- not to exceed sixty months.

Signed: x Jim Green date

Improvement Permit by: P.C. Moore date 9-13-99

Authorization to Construct by: P.C. moore date 9-13-99

Installed by: A-1 Backhoe

Operation Permit by P.C moore date 9-24-99

Existing System Inspection by: date

HEALTH DEPT COPY WHITE OWNER COPY (FINAL) YELLOW OWNER COPY (INITIAL) PINK