IREDELL COUNTY HEALTH DEPARTMENT

STATESVILLE 704-878-5305 MOORESVILLE 704-664-5281

IMPROVEMENT PERMIT / AUTHORIZATION TO CONSTRUCT / OPERATION PERMIT / EXISTING SYSTEM INSPECTI

PERMIT# 79253 PIN# 4762516439 DATE 2-12-99

OWNER OR CONTRACTOR Robert Lawson PHONE: Business Home 3367773259

ADDRESS 2507 Stockton St Winston Salem N.C.

LOCATION Amity Hill TL Bethania TR Hickory Nut 16th lot left

SUBDIVISION Laurel Grove BLOCK / SECTION LOT 16 LOT AREA 1.3 acres SITE CLASS PS DESIGN FLOW 3 L.T.A.R. .3

Septic Tank: 1000 Gallons: STB 1012 Date 1-8-99
Pump Tank: Gallons: PT Date
Pump Make: Model Serial No.
Nitrification Field: No Fields 1 Square Feet 1200 Linear Feet 400
No Lines 3 Trench Width 36" Max Trench Bottom Depth 36

(X) New System ( ) Repair System Type: (X) II, IV, V, VI
System Description: Conv. Gravity
Repair System Description:
Maintenance Agreement Required: ( ) Yes (X) No
Gravel Depth 12"

( ) House/Mod. Home No. Bedrooms 3
(X) Mobile Home No. Bathrooms 2
( ) Business No. Employees
( ) Other


(X) Slab ( ) Crawl Space ( ) Basement w/plumbing ( ) Basement wo/plumbing

Water Supply: (X) Individual ☐ Public ☐ Community


Comments/Conditions:

Comments/Conditions: Same as initial sketch

INITIAL SITE SKETCH

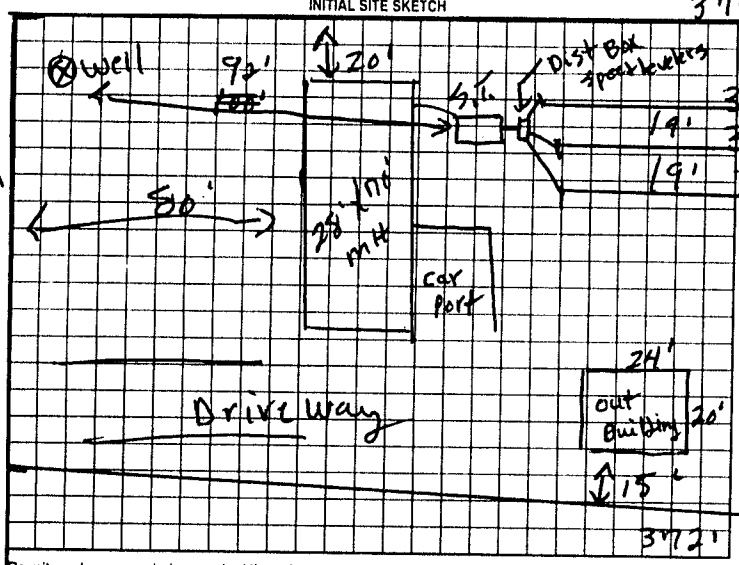

AS BUILT SKETCH

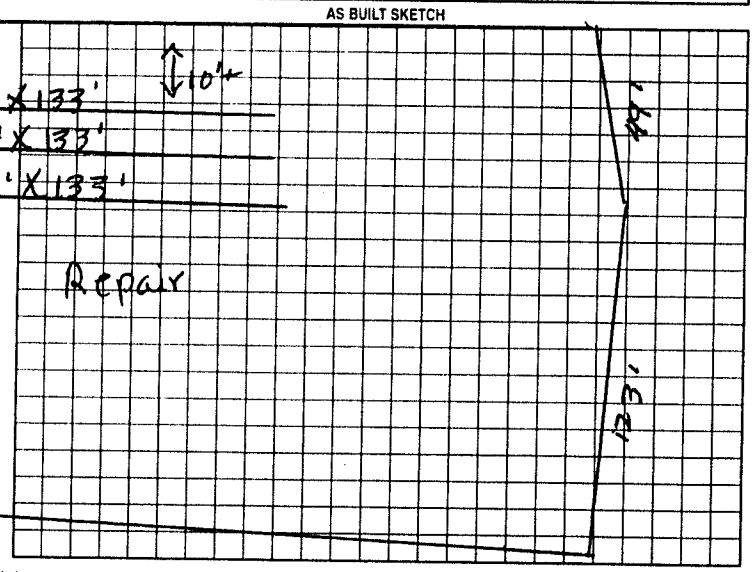

Permit can be suspended or revoked if any false information is supplied toward securing the permit/any unauthorized changes are made to the site/any unauthorized changes are made in the installation of the system. Improvement Permit with plat valid without expiration. Improvement Permit with site plan valid for sixty months. Authorization to Construct is valid for a period equal to that of Improvement Permit – not to exceed sixty months.

Signed: [signature] date 2/17/99 Installed by: A-1 Backhoe

Improvement Permit by: R. C. Moore date 2-12-99 Operation Permit by: R. C. Moore date 3-19-99

Authorization to Construct by: R. C. Moore date 2-12-99 Existing System Inspection by: date

HEALTH DEPT COPY WHITE OWNER COPY (FINAL) YELLOW OWNER COPY (INITIAL) PINK