IREDELL COUNTY HEALTH DEPARTMENT

STATESVILLE 704-878-5305 MOORESVILLE 704-664-5281

IMPROVEMENT PERMIT / AUTHORIZATION TO CONSTRUCT / OPERATION PERMIT / EXISTING SYSTEM INSPECTION

PERMIT# 079379 PIN# 4762569181 DATE 2-18-99

OWNER OR CONTRACTOR Wayne Dennis Elmore PHONE: Business _____ Home 336-838-2304

ADDRESS 600 Ancient Oak Dr Wilkesboro

LOCATION 70E TR Bethesda TL Cornflower TR Pine Tree TR Cypress atend on R

SUBDIVISION Pine Tree BLOCK / SECTION _____ LOT 15B LOT AREA 2.81 SITE CLASS. _____ DESIGN FLOW 240 L.T.A.R. _____

Septic Tank: Existing Gallons; STB _____ Date _____
Pump Tank: 2 Gallons; PT _____ Date _____
Pump Make: _____ Model _____ Serial No. _____
Nitrification Field: No Fields ____ Square Feet _____ Linear Feet _____
No Lines _____ Trench Width _____ Max Trench Bottom Depth _____ Gravel Depth _____

☐ New System ☐ Repair System Type: I, II, III, IV, V, VI
System Description: _____
Repair System Description: _____
Maintenance Agreement Required: ☐ Yes ☐ No
☐ Slab ☒ Crawl Space ☐ Basement w/plumbing ☐ Basement wo/plumbing


☐ House/Mod. Home No. Bedrooms 2
☒ Mobile Home No. Bathrooms 2
☐ Business No. Employees ____
☐ Other _____

Water Supply: ☒ Individual ☐ Public ☐ Community


Comments/Conditions:

Comments/Conditions:
Existing System Check.
keep Footels 5ft from tank

INITIAL SITE SKETCH

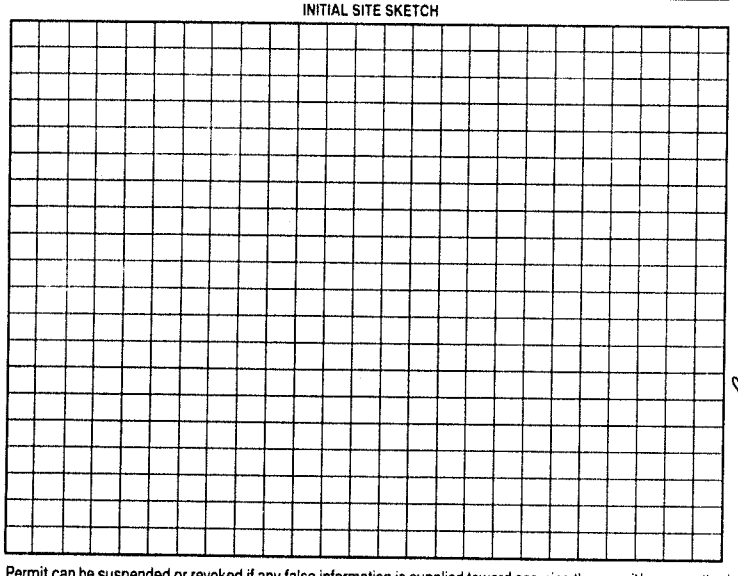

AS BUILT SKETCH

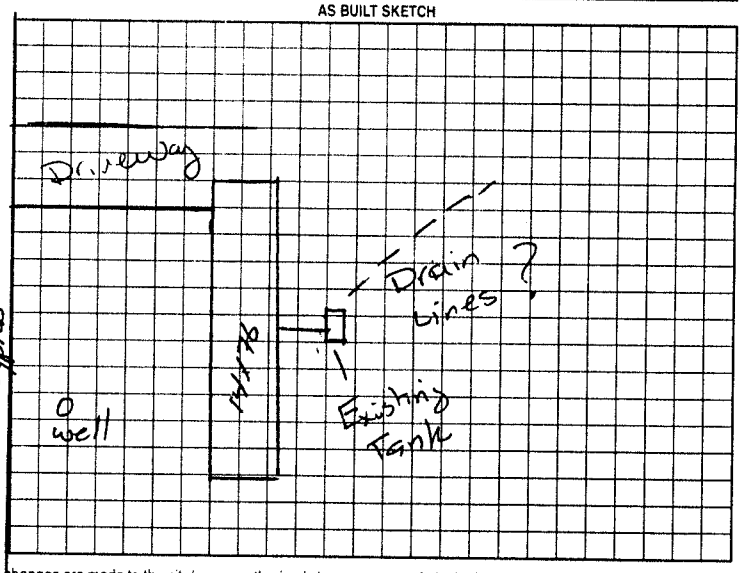

Permit can be suspended or revoked if any false information is supplied toward securing the permit/any unauthorized changes are made to the site/any unauthorized changes are made in the installation of the system. Improvement Permit with plat valid without expiration. Improvement Permit with site plan valid for sixty months. Authorization to Construct is valid for a period equal to that of Improvement Permit – not to exceed sixty months.

Signed: _____ date _____ Installed by: _____

Improvement Permit by: _____ date _____ Operation Permit by: _____ date _____

Authorization to Construct by: _____ date _____ Existing System Inspection by: Mark Clark RS date 2-18-99

HEALTH DEPT COPY: WHITE OWNER COPY (FINAL) YELLOW OWNER COPY (INITIAL): PINK