IREDELL COUNTY HEALTH DEPARTMENT

THIS PERMIT VOIDS PREVIOUS ISSUED 7-15-03 CF

STATESVILLE 704-878-5305 MOORESVILLE 704-664-5281

IMPROVEMENT PERMIT / AUTHORIZATION TO CONSTRUCT / OPERATION PERMIT / EXISTING SYSTEM INSPECTION

PERMIT# 115293 PIN# 4762-61-3384

OWNER OR CONTRACTOR MARGARITA ALEMAN PHONE: Business 704-278-2734 Home 704-657-7816 DATE 10-28-03

ADDRESS 260 PHIFER ROAD, CLEVELAND, NC 27013

LOCATION US 70 EAST, TR BETHESDA ROAD, TL HICKORY NUT, TR BREEZEWAY LANE, LOT AT END ON LEFT

SUBDIVISION LAUREL GROVE BLOCK / SECTION ____ LOT 34 LOT AREA 2.75 ACRES SITE CLASS. PS DESIGN FLOW 480 L.T.A.R. 0.30 GPD/FT²

Septic Tank: 1000 Gallons; STB 760 Date 7-26-03

Pump Tank: ____ Gallons; PT ____ Date ____

Pump Make: ____ Model ____ Serial No. ____

Nitrification Field: No Fields 1 Square Feet 1600 Linear Feet 400

No Lines FOUR Trench Width 36" Max Trench Bottom Depth 36"

☑ New System ☐ Repair System Type: I, II, III, IV, V, VI

System Description: 25% REDUCTION, GRAVITY

Repair System Description: CONVENTIONAL, GRAVITY

Maintenance Agreement Required: ☐ Yes ☑ No

Gravel Depth N/A

☐ House/Mod. Home ☑ Mobile Home ☐ Business ☐ Other

No. Bedrooms 4 No. Bathrooms 3 No. Employees ____


☐ Slab ☑ Crawl Space ☐ Basement w/plumbing ☐ Basement wo/plumbing

Water Supply: ☑ Individual ☐ Public ☐ Community WELL


Comments:/Conditions: INSTALL 25% REDUCTION SYSTEM ON CONTOUR AS FLAGGED ② KEEP SYSTEM MINIMUM 100' FROM WELLS.

Comments:/Conditions: ZABEL FILTER & MARKER SYSTEM INSTALLED AS FLAGGED. LAST LINE IS 10' OFF P/L & SUPPLY LINE IS 5' OFF P/L.

INITIAL SITE SKETCH

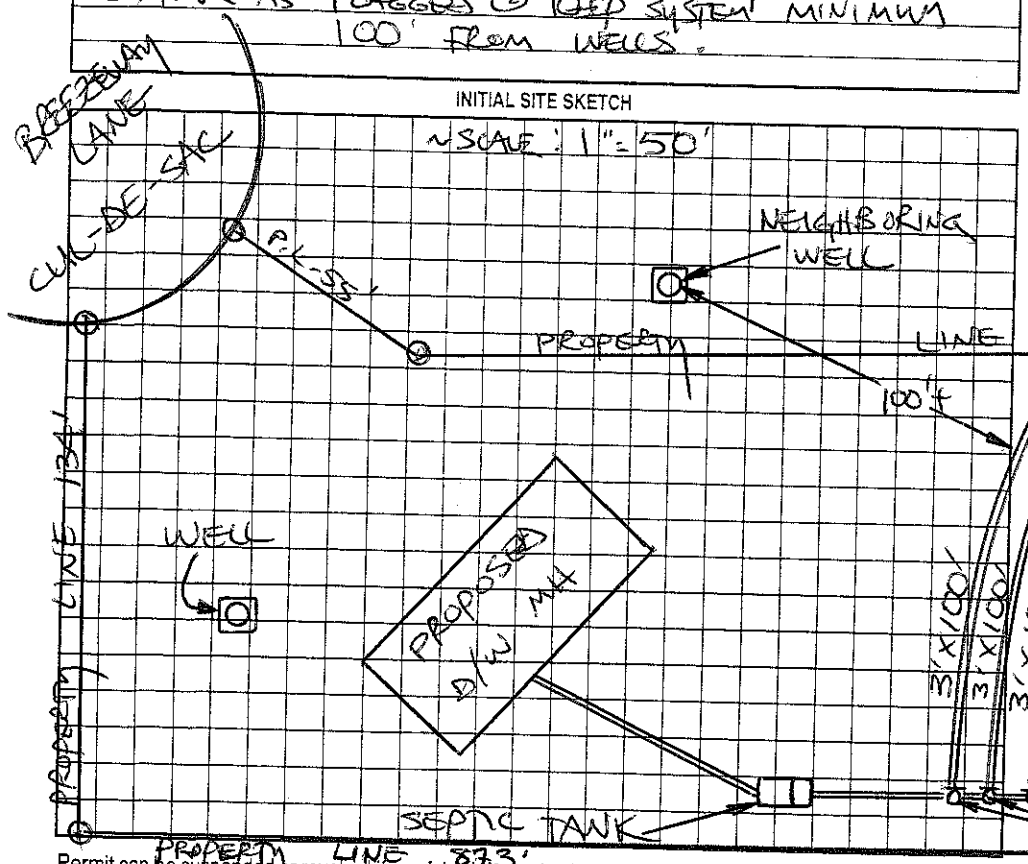

AS BUILT SKETCH

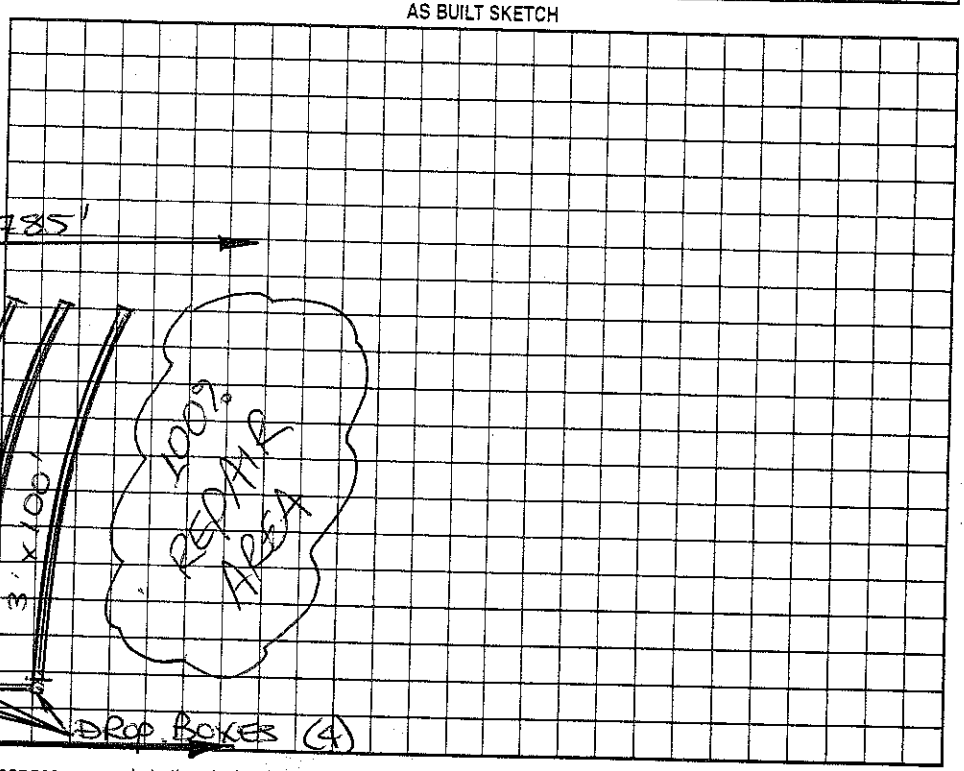

Permit can be suspended or revoked if any false information is supplied toward securing the permit/any unauthorized changes are made to the site/any unauthorized changes are made in the installation of the system. Improvement Permit with plat valid without expiration. Improvement Permit with site plan valid for sixty months. Authorization to Construct is valid for a period equal to that of Improvement Permit – not to exceed sixty months.

Signed: Margarita D' Aleman 10/29/03 date ____

Improvement Permit by: STEVE HEDRICK date 10-28-03

Authorization to Construct by: STEVE HEDRICK date 10-28-03

Installed by: BOB'S BACKHOE

Operation Permit by: [signature] date 12-2-03

Existing System Inspection by: ____ date ____

HEALTH DEPT. COPY: WHITE OWNER COPY (FINAL): YELLOW OWNER COPY (INITIAL): PINK