IREDELL COUNTY HEALTH DEPARTMENT

STATESVILLE 704-878-5305 MOORESVILLE 704-664-5281

IMPROVEMENT PERMIT / AUTHORIZATION TO CONSTRUCT / OPERATION PERMIT / EXISTING SYSTEM INSPECTION

PERMIT# 77979 PIN# 4762516439 DATE 10-25-99

OWNER OR CONTRACTOR Joseph Blackwelder PHONE: Business 528 3320 Home

ADDRESS 126 Country Lane Troutman N.C.

LOCATION 70 E IR Bethesda TL Hickory Nut TR Breezeway 8th lot left

SUBDIVISION Laural Grove BLOCK / SECTION LOT 32 LOT AREA 2.44 acres SITE CLASS PS DESIGN FLOW 480 L.T.A.R. .13

Septic Tank: 1000 Gallons; STB 1017 Date 8-24-99
Pump Tank: Gallons; PT Date
Pump Make: Model Serial No
Nitrification Field: No Fields 1 Square Feet 1600 Linear Feet 533
No Lines 6 Trench Width 36" Max Trench Bottom Depth 36" Gravel Depth 12"

☑ New System ☐ Repair System Type: I. II. III. IV. V. VI
System Description: Conv. Gravity
Repair System Description:
Maintenance Agreement Required: ☐ Yes ☐ No


☐ House/Mod. Home ☑ Mobile Home ☐ Business ☐ Other
No. Bedrooms 4 No. Bathrooms 2 No. Employees
☐ Slab ☐ Crawl Space ☐ Basement w/plumbing ☐ Basement wo/plumbing

Water Supply: ☑ Individual ☐ Public ☐ Community

Comments:/Conditions:
Replaces Permit Issued TO American Land 12-15-98

Comments:/Conditions

INITIAL SITE SKETCH

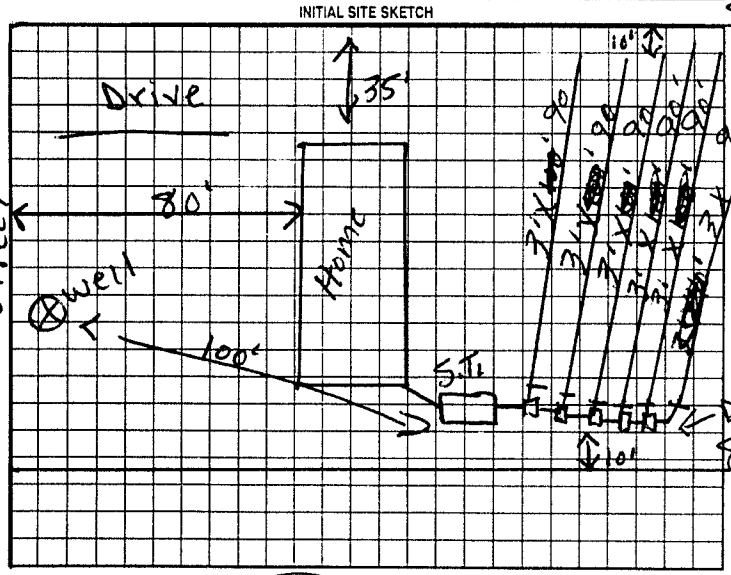

852'

AS BUILT SKETCH

Same as initial Sketch Except Line lengths are as shown

Permit can be suspended or revoked if any false information is supplied toward securing the permit/any unauthorized changes are made to the site/any unauthorized changes are made in the installation of the system. Improvement Permit with plat valid without expiration. Improvement Permit with site plan valid for sixty months. Authorization to Construct is valid for a period equal to that of Improvement Permit – not to exceed sixty months.

Signed: Jim Teeler date 10-28-99 Installed by: A-1 Backhoe

Improvement Permit by: R. C. Moore date 10-25-99 Operation Permit by: R. C. Moore date 11-9-99

Authorization to Construct by: R. C. Moore date 10-25-99 Existing System Inspection by: date

HEALTH DEPT. COPY WHITE OWNER COPY (FINAL) YELLOW OWNER COPY (INITIAL) PINK