IREDELL COUNTY HEALTH DEPARTMENT

STATESVILLE 704-878-5305 MOORESVILLE 704-664-5281 CI

IMPROVEMENT PERMIT / AUTHORIZATION TO CONSTRUCT / OPERATION PERMIT / EXISTING SYSTEM INSPECTION

PERMIT# 105586 PIN# 4762-62-0962 DATE 4/10/02

OWNER OR CONTRACTOR Lionel Velez PHONE: Business — Home (704) 528-2616

ADDRESS 209 Hickory Nut Drive Statesville N.C. 28677

LOCATION 70E, (R) on Bethesda, (L) Hickory Nut, go (L) across from Breezeway Lane

SUBDIVISION Laurel Grove BLOCK / SECTION — LOT 17 LOT AREA 1.07 SITE CLASS PS DESIGN FLOW 440 L.T.A.R. .3

Septic Tank: 1000 Gallons: STB EXISTING Date —
Pump Tank: — Gallons: PT — Date —
Pump Make: — Model — Serial No. —
Nitrification Field: No Fields 1 Square Feet 400 Linear Feet 134
No Lines 1 @ 134 Trench Width 36" Max Trench Bottom Depth 36" Gravel Depth 12"

[X] New System [ ] Repair System Type: I II III IV V VI
System Description: Conv. Gravity
Repair System Description: Gravity, 50% Red.
Maintenance Agreement Required: [ ] Yes [X] No
[ ] Slab [X] Crawl Space [ ] Basement w/plumbing [ ] Basement wo/plumbing


[ ] House/Mod Home [X] Mobile Home [ ] Business [ ] Other
No. Bedrooms 4 No. Bathrooms 2 No. Employees —

Water Supply: [X] Individual [ ] Public [ ] Community


Comments/Conditions: (1) Add One (1) 134-ft line on contour (2) Replace Distribution box w/speed leveler if necessary to add New line to System. (3) This New line must be completed in 30 day From issuance of permit

Comments/Conditions: SPEED LEVELERS SET EQUAL

INITIAL SITE SKETCH

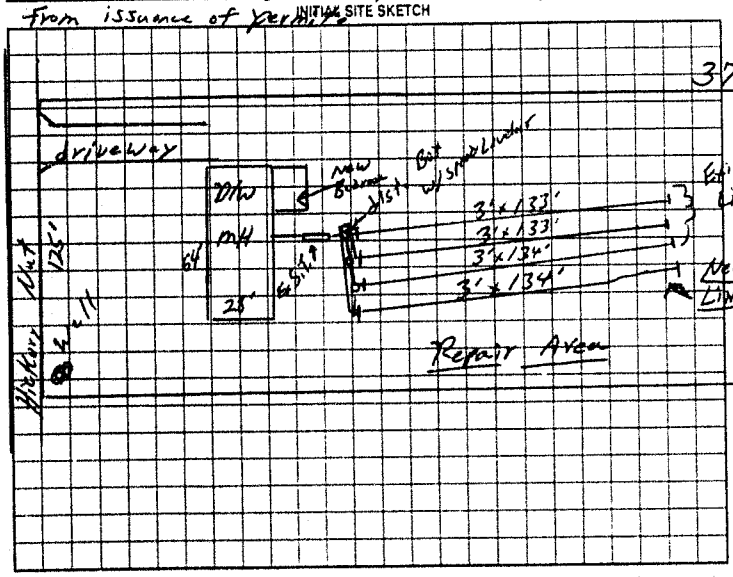

AS BUILT SKETCH

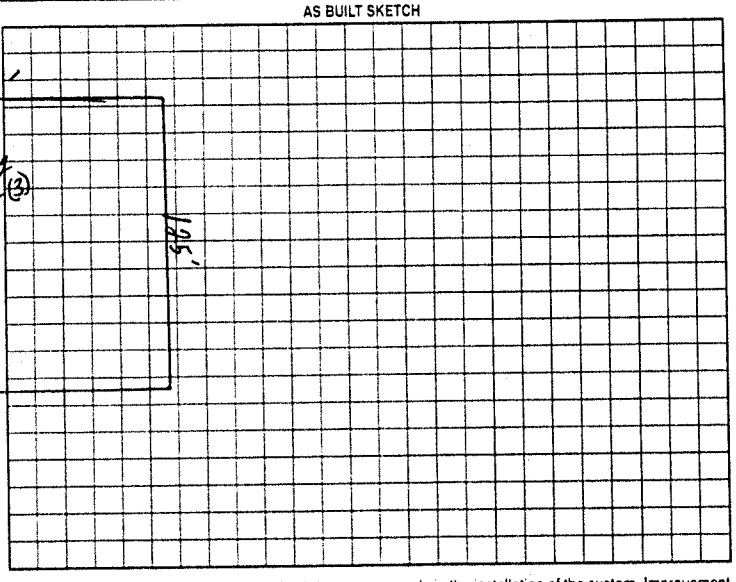

Permit can be suspended or revoked if any false information is supplied toward securing the permit/any unauthorized changes are made to the site/any unauthorized changes are made in the installation of the system. Improvement Permit with plat valid without expiration. Improvement Permit with site plan valid for sixty months. Authorization to Construct is valid for a period equal to that of Improvement Permit – not to exceed sixty months.

Signed: Evelyn Martin date 4-15-02

Improvement Permit by: William A. Johnson date 4/10/02

Authorization to Construct by: William A. Johnson date 4/10/02

Installed by BARRY STOMP A

Operation Permit by: [signature] RS date 04-25-02

Existing System Inspection by: — date —

HEALTH DEPT COPY WHITE OWNER COPY (FINAL) YELLOW OWNER COPY (INITIAL) PINK