IREDELL COUNTY HEALTH DEPARTMENT

STATESVILLE 704-878-5305 MOORESVILLE 704-664-5281

IMPROVEMENT PERMIT / AUTHORIZATION TO CONSTRUCT / OPERATION PERMIT / EXISTING SYSTEM INSPECTION

PERMIT# 80925 PIN# 4762620962 DATE 5-5-99

OWNER OR CONTRACTOR Lionel Velez PHONE: Business _____ Home 660 0251

ADDRESS 1002 Snowden Dr Lakeworth FL

LOCATION 70 E TR Bethesda TL Hickory Nut 17th lot left.

SUBDIVISION Laurel Grove BLOCK / SECTION _____ LOT 17 LOT AREA 1.0 acres SITE CLASS PS DESIGN FLOW 360 L.T.A.R. .13

Septic Tank: 1000 Gallons; STB 1012 Date 3-27-99

Pump Tank: _____ Gallons; PT _____ Date _____

Pump Make: _____ Model _____ Serial No. _____

Nitrification Field: No Fields 1 Square Feet 1200 Linear Feet 400

No Lines 3 Trench Width 36" Max Trench Bottom Depth 36" Gravel Depth 12"

☒ New System ☐ Repair System Type: ☐ I ☐ II ☐ III ☐ IV ☐ V ☐ VI

System Description: Conv. Gravity

Repair System Description Gravity 25% Red.

Maintenance Agreement Required: Yes ☐ No ☒

☐ House/Mod. Home ☒ Mobile Home ☐ Business ☐ Other

No. Bedrooms 3 No. Bathrooms ____ No. Employees ____


☐ Slab ☒ Crawl Space ☐ Basement w/plumbing ☐ Basement wo/plumbing

Water Supply: ☒ Individual ☐ Public ☐ Community


Comments/Conditions:

Comments/Conditions:

INITIAL SITE SKETCH

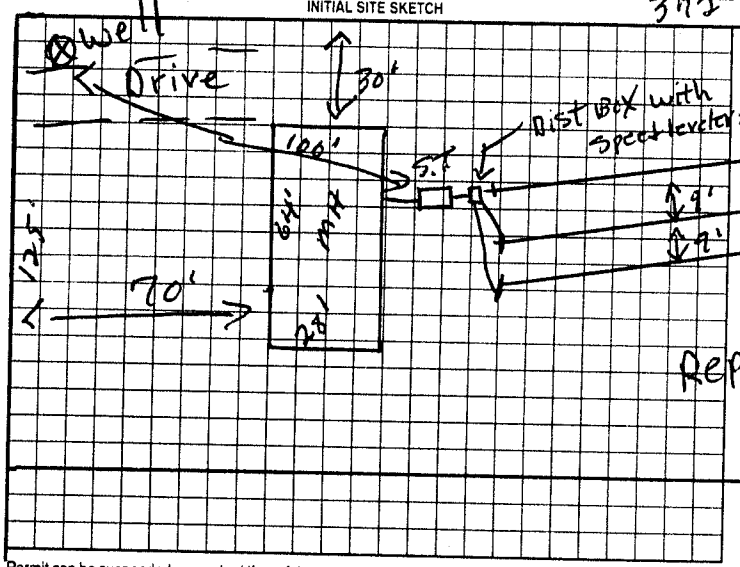

AS BUILT SKETCH

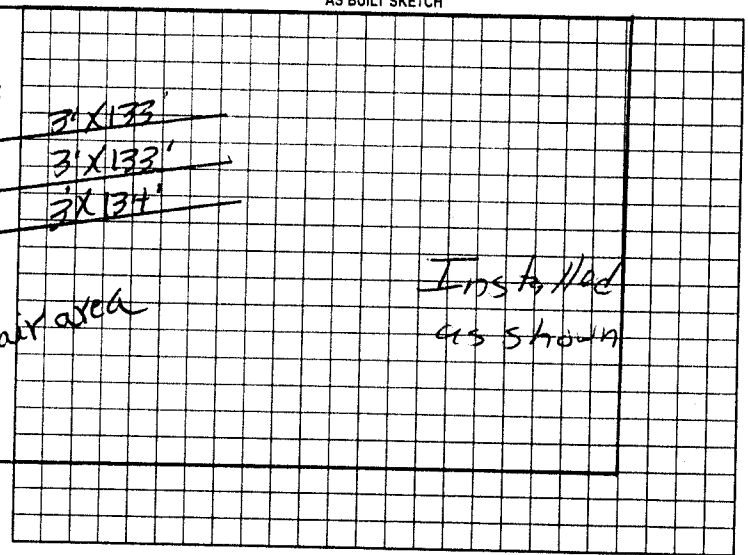

Permit can be suspended or revoked if any false information is supplied toward securing the permit/any unauthorized changes are made to the site/any unauthorized changes are made in the installation of the system. Improvement Permit with plat valid without expiration. Improvement Permit with site plan valid for sixty months. Authorization to Construct is valid for a period equal to that of Improvement Permit – not to exceed sixty months.

Signed: Sherri Hoke-Seawright date 5-13-99 Installed by: A-1 Backhoe

Improvement Permit by: J. C. Moore date 5-5-99 Operation Permit by: Mary C Outlaws date 5-17-99

Authorization to Construct by: J. C. Moore date 5-5-99 Existing System Inspection by: _____ date _____

HEALTH DEPT. COPY: WHITE OWNER COPY (FINAL): YELLOW OWNER COPY (INITIAL): PINK