IREDELL COUNTY HEALTH DEPARTMENT

STATESVILLE 704-878-5305 MOORESVILLE 704-664-5281

IMPROVEMENT PERMIT / AUTHORIZATION TO CONSTRUCT / OPERATION PERMIT / EXISTING SYSTEM INSPECTION

PERMIT# 80559 PIN# 4672681663 DATE 4-14-99

OWNER OR CONTRACTOR Jason Lester PHONE: Business _____ Home 704 8789585

ADDRESS 121 Cara Ln Statesville, N.C.

LOCATION 70 E TR Bethela Rd Tb Hickory Nut 1/4mi RT

SUBDIVISION Laurel Grove BLOCK / SECTION _____ LOT 25 LOT AREA 1.02 acres SITE CLASS PS DESIGN FLOW 360 L.T.A.R. .3

Septic Tank: 1000 Gallons; STB 825 Date 3-18-99
Pump Tank: _____ Gallons; PT _____ Date _____
Pump Make: _____ Model _____ Serial No. _____
Nitrification Field: No Fields 1 Square Feet 1200 Linear Feet 400
No Lines 4 Trench Width 36" Max Trench Bottom Depth 36" Gravel Depth 12"

☒ New System ☐ Repair System Type: ☒ I, ☐ II, ☐ III, ☐ IV, ☐ V, ☐ VI
System Description: Conv. Gravity
Repair System Description: " "
Maintenance Agreement Required: ☐ Yes ☐ No
☐ Slab ☐ Crawl Space ☐ Basement w/plumbing ☐ Basement wo/plumbing


☐ House/Mod. Home No. Bedrooms 3
☐ Mobile Home No. Bathrooms 2
☐ Business No. Employees _____
☐ Other _____

Water Supply:
☒ Individual
☐ Public
☐ Community

Comments/Conditions:


Comments/Conditions:

INITIAL SITE SKETCH

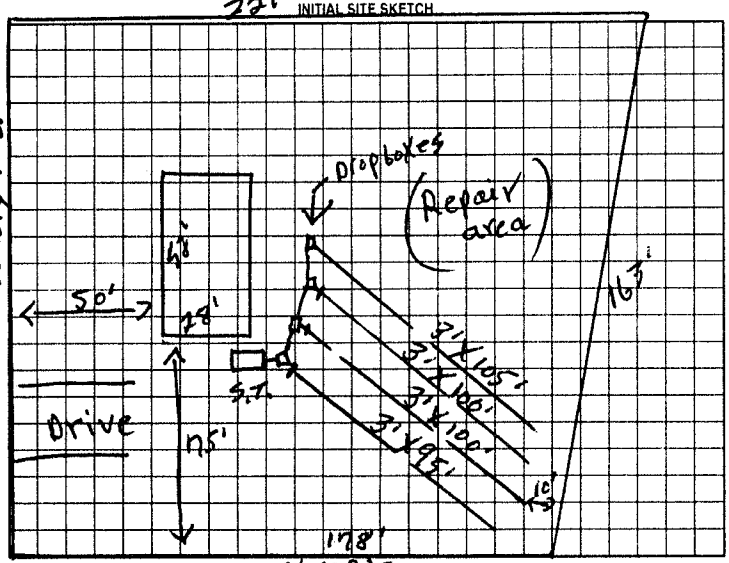

180' Hickory Nut

AS BUILT SKETCH

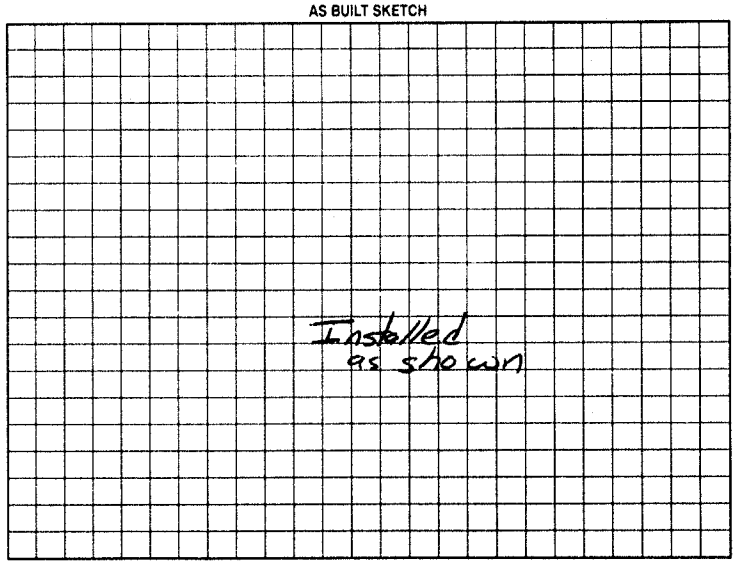

Permit can be suspended or revoked if any false information is supplied toward securing the permit/any unauthorized changes are made to the site/any unauthorized changes are made in the installation of the system. Improvement Permit with plat valid without expiration. Improvement Permit with site plan valid for sixty months. Authorization to Construct is valid for a period equal to that of Improvement Permit -- not to exceed sixty months.

Signed: Sherrill Hayes-Seaver date 4-25-99

Improvement Permit by: J. C. Moore date 4-14-99

Authorization to Construct by: J. C. Moore date 4-14-99

Installed by: Upright Grading & Septic

Operation Permit by: [illegible] date 5-7-99

Existing System Inspection by: _____ date _____

HEALTH DEPT. COPY WHITE OWNER COPY (FINAL) YELLOW OWNER COPY (INITIAL) PINK