IREDELL COUNTY HEALTH DEPARTMENT

STATESVILLE 704-878-5305 MOORESVILLE 704-664-5281

IMPROVEMENT PERMIT / AUTHORIZATION TO CONSTRUCT / OPERATION PERMIT / EXISTING SYSTEM INSPECTION

PERMIT# 80557 PIN# 4762623912 DATE 4-27-99

OWNER OR CONTRACTOR Howard Dempsey PHONE: Business 8789595 Home

ADDRESS 831 Beaty St Apt C1 Davidson N.C.

LOCATION 70E TR Bethesda To Hickory Nut 19th Home left

SUBDIVISION Laurel Grove BLOCK / SECTION LOT 19 LOT AREA 1.01 acres SITE CLASS PS DESIGN FLOW 360 L.T.A.R. .13

Septic Tank: 1000 Gallons; STB 1012 Date 3-9-99

Pump Tank: Gallons; PT Date

Pump Make: Model Serial No.

Nitrification Field: No Fields 1 Square Feet 900 Linear Feet 300

No Lines 6 Trench Width 36" Max Trench Bottom Depth 36" Gravel Depth N/A

[x] New System [ ] Repair System Type: I. II. III. IV. V. VI

System Description: Gravity 25% Reduction

Repair System Description: Pump To 25% Red.

Maintenance Agreement Required: [ ] Yes [x] No

[ ] House/Mod. Home No. Bedrooms 3

[ ] Mobile Home No. Bathrooms 2

[ ] Business No. Employees

[ ] Other


[ ] Slab [ ] Crawl Space [ ] Basement w/plumbing [ ] Basement wo/plumbing

Water Supply: [x] Individual [ ] Public [ ] Community


Comments/Conditions:

Comments/Conditions.

INITIAL SITE SKETCH

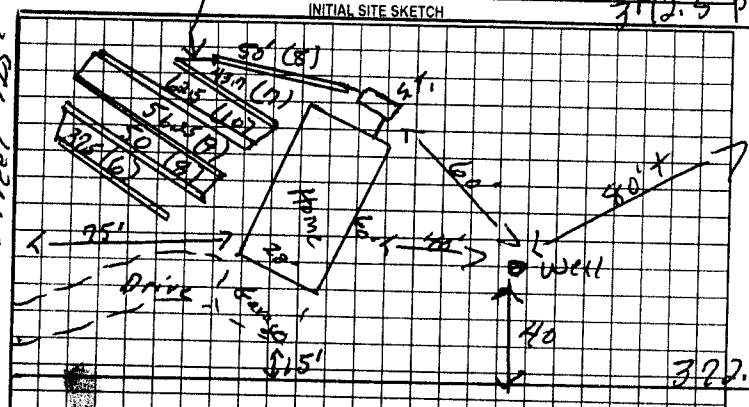

AS BUILT SKETCH

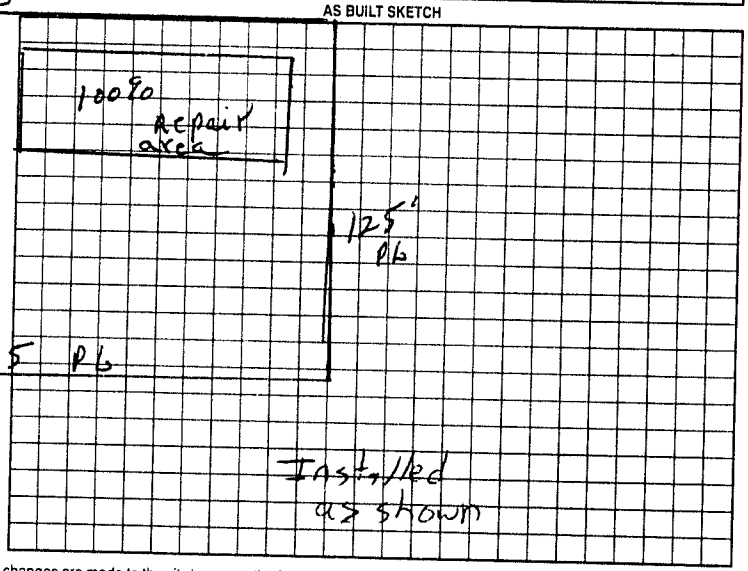

Permit can be suspended or revoked if any false information is supplied toward securing the permit/any unauthorized changes are made to the site/any unauthorized changes are made in the installation of the system. Improvement Permit with plat valid without expiration. Improvement Permit with site plan valid for sixty months. Authorization to Construct is valid for a period equal to that of Improvement Permit – not to exceed sixty months.

Signed: Steven McRae Jr. agent date 4-28-99 Installed by: A-1 Backhoe

Improvement Permit by: R.C. Moore date 4-27-99 Operation Permit by: Mac Coates date 5-5-99

Authorization to Construct by: R.C. Moore date 4-27-99 Existing System Inspection by: date

HEALTH DEPT. COPY: WHITE OWNER COPY (FINAL) YELLOW OWNER COPY (INITIAL) PINK