IREDELL COUNTY HEALTH DEPARTMENT

STATESVILLE 704-878-5305 MOORESVILLE 704-664-5281

IMPROVEMENT PERMIT / AUTHORIZATION TO CONSTRUCT / OPERATION PERMIT / EXISTING SYSTEM INSPECTION

PERMIT# 83426 PIN# 4762624020 DATE 9-3-99

OWNER OR CONTRACTOR Jonathan Shepard PHONE: Business 704-855-4744 Home

ADDRESS 886 Bailey Farm Rd Statesville

LOCATION 70 E TR / Bethesda TL Hickory Nut TR Breezeway 600' left

SUBDIVISION Laurel Grove BLOCK / SECTION LOT 29 LOT AREA 3.17 acres SITE CLASS PS DESIGN FLOW 360 L.T.A.R. .33

Septic Tank: 1000 Gallons; STB 825 Date 9-14-99

Pump Tank: Gallons; PT Date

Pump Make: Model Serial No.

Nitrification Field: No Fields 1 Square Feet 1080 Linear Feet 360

No Lines 3 Trench Width 36" Max Trench Bottom Depth 36" Gravel Depth 12"

~~New System~~ Repair System Type: I II III IV V VI

System Description: Conv. Gravity

Repair System Description:

Maintenance Agreement Required: Yes ~~No~~

~~House/Mod. Home~~ Mobile Home Business Other

No. Bedrooms 3 No. Bathrooms 2 No. Employees


Water Supply: ☐ Individual ☐ Public ☐ Community

~~Slab~~ Crawl Space Basement w/plumbing Basement wo/plumbing


Comments/Conditions:

Comments/Conditions: same as initial sketch except line length as shown

INITIAL SITE SKETCH

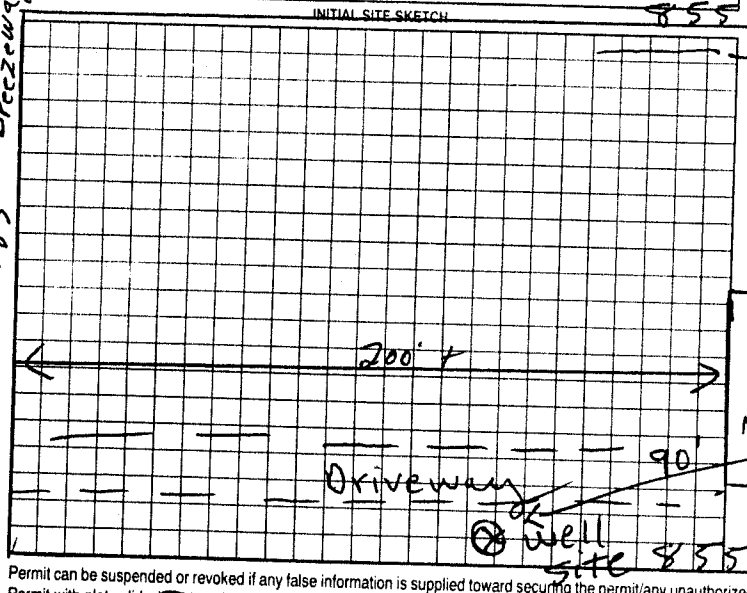

AS BUILT SKETCH

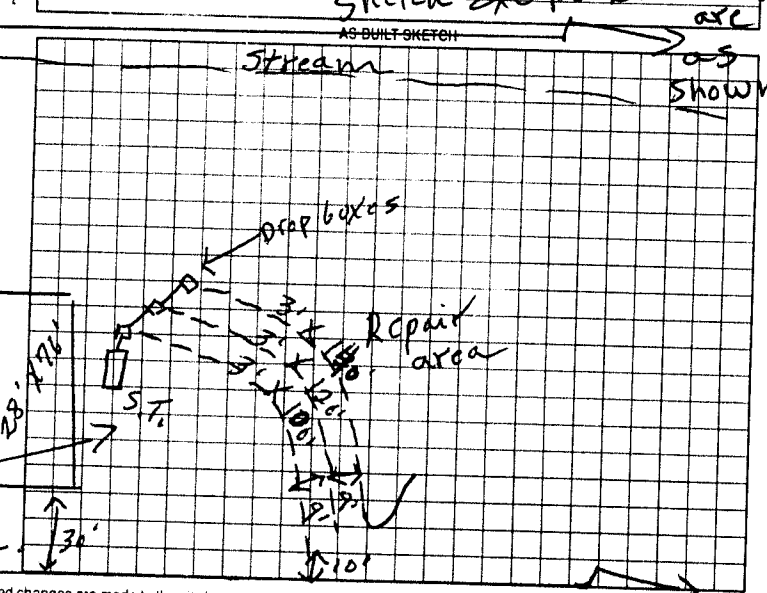

183' Breezeway Dr.

Permit can be suspended or revoked if any false information is supplied toward securing the permit/any unauthorized changes are made to the site/any unauthorized changes are made in the installation of the system. Improvement Permit with plat valid without expiration. Improvement Permit with site plan valid for sixty months. Authorization to Construct is valid for a period equal to that of Improvement Permit – not to exceed sixty months.

Signed: X Lonnie A. Milam date 9/3/99 Installed by: Potter Grading (Davidson Co.)

Improvement Permit by: J.C. moore date 9-3-99 Operation Permit by: J.C. moore date 11-5-99

Authorization to Construct by: J.C. moore date 9-3-99 Existing System Inspection by: date

HEALTH DEPT. COPY: WHITE OWNER COPY (FINAL): YELLOW OWNER COPY (INITIAL): PINK