IREDELL COUNTY HEALTH DEPARTMENT

STATESVILLE 704-878-5305 (C) MOORESVILLE 704-664-5281

IMPROVEMENT PERMIT / AUTHORIZATION TO CONSTRUCT / OPERATION PERMIT / EXISTING SYSTEM INSPECTION

PERMIT# 105627 PIN# 4762-63-5090 DATE 04-23-02

OWNER OR CONTRACTOR OAKWOOD HOMES / AMERICAN LAND CORP PHONE Business 704-528-4516 Home

ADDRESS 231 HICKORY NUT DR. STATESVILLE NC 28677

LOCATION 70E, (R) BETHESDA (L) HICKORY NUT, ATEND ON LEFT

SUBDIVISION LAUREL GROVE BLOCK / SECTION LOT 21 LOT AREA 1.64 AC SITE CLASS B DESIGN FLOW 360 L.T.A.R. .3

Septic Tank: 1000 Gallons: STB 1012 Date 2-4-02
Pump Tank: Gallons: PT Date
Pump Make: Model Serial No.
Nitrification Field: No Fields 1 Square Feet EQ#120' Linear Feet 300'
No Lines 5X60' Trench Width 36" Max Trench Bottom Depth 36" Gravel Depth N/A

X New System ☐ Repair System Type: I. II (III) IV. V VI
System Description: GRAV ESER REDUCT
Repair System Description: Pump 250 REDUCT
Maintenance Agreement Required: ☐ Yes X No
☐ Slab X Crawl Space ☐ Basement w/plumbing ☐ Basement wo/plumbing

☐ House/Mod. Home No Bedrooms 3
X Mobile Home No Bathrooms 2
☐ Business No Employees
☐ Other


Water Supply: X Individual ☐ Public ☐ Community
WELL

Comments/Conditions: (1) HOUSE SITE SLID UP 45' FROM ORIGINAL PLATE, NEW HOUSE SITE STAKED OUT WITH RED FLAGS, (2) INSTALL LINES ON CONTOURS


Comments/Conditions (3) MAINTAIN SETBACKS (4) INSTALL LINES ON CONTOURS (5) INSTALLED DURING VERY WET SOIL CONDITIONS.

TO CUL-DE-SAC

INITIAL SITE SKETCH

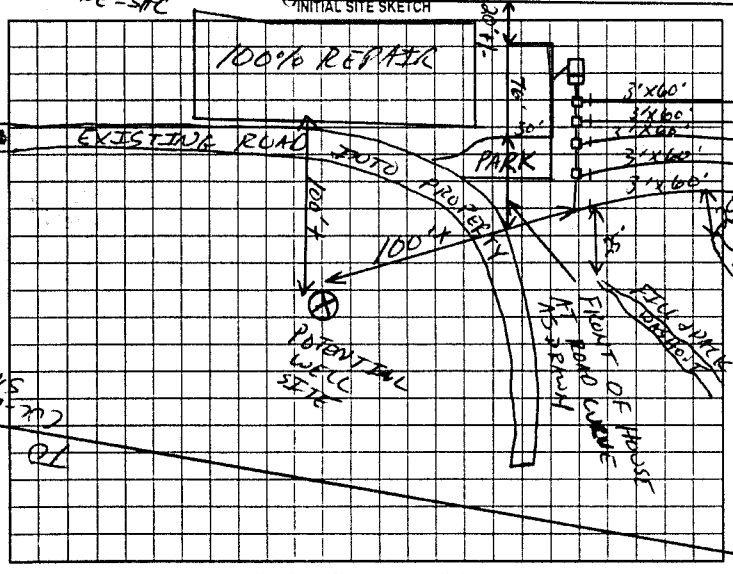

AS BUILT SKETCH

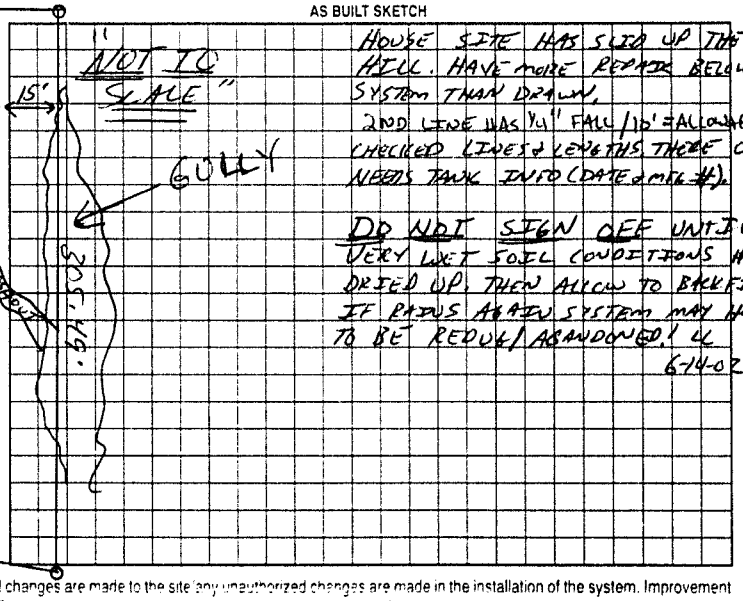

HOUSE SITE HAS SLID UP THE HILL. HAVE MORE REPAIR BELOW SYSTEM THAN DRAWN. 2ND LINE WAS 4.1' FALL / 15' = ALLOWABLE CHECKED LINES & LENGTHS THERE OK. NEEDS TANK INFO (DATE & MFG #).

DO NOT SIGN OFF UNTIL VERY WET SOIL CONDITIONS HAVE DRIED UP. THEN ALLOW TO BACKFILL. IF RAINS AGAIN SYSTEM MAY HAVE TO BE REDUCED / ABANDONED! LC 6-14-02

Permit can be suspended or revoked if any false information is supplied toward securing the permit/any unauthorized changes are made to the site/any unauthorized changes are made in the installation of the system. Improvement Permit with plat valid without expiration. Improvement Permit with site plan valid for sixty months. Authorization to Construct is valid for a period equal to that of Improvement Permit - not to exceed sixty months

Signed: Larry W. Mosely date 4-24-02 Installed by CRAIG THOMPSON

Improvement Permit by: date 04-23-02 Operation Permit by STEVE HEDRICK date 6-17-02

Authorization to Construct by: date 04-23-02 Existing System Inspection by: date

HEALTH DEPT COPY WHITE OWNER COPY (FINAL) YELLOW OWNER COPY (INITIAL) PINK