IREDELL COUNTY HEALTH DEPARTMENT

STATESVILLE 704-878-5305 (LV) MOORESVILLE 704-664-5281

IMPROVEMENT PERMIT / AUTHORIZATION TO CONSTRUCT / OPERATION PERMIT / EXISTING SYSTEM INSPECTION

PERMIT# 104303 PIN# 4762-67-7787 DATE 2-12-02

OWNER OR CONTRACTOR JACKIE P. PAYNE PHONE: Business (704) 873-7703 Home (704) 871-0304

ADDRESS 157 CYPRUS LANE, W STATESVILLE, NC 28677

LOCATION US 70 E, TR BETHESDA, TL CORNFLOWER, TR PINE TREE, TR CYPRUS, LOT ON LEFT BEFORE CURVE

SUBDIVISION PINE TREE FARMS BLOCK / SECTION ____ LOT 33 LOT AREA 1 ACRE SITE CLASS PS DESIGN FLOW 360 L.T.A.R. 0.25 GPD/FT²

Septic Tank: 1000 Gallons; STB 1012 Date 2-19-02
Pump Tank: ____ Gallons; PT ____ Date ____
Pump Make: ____ Model ____ Serial No. ____
Nitrification Field: No Fields 1 Square Feet 1440 Linear Feet 480
No Lines FIVE Trench Width 36" Max Trench Bottom Depth 36" Gravel Depth 12"

☒ New System ☐ Repair System Type: I (II) III. IV. V. VI
System Description: CONVENTIONAL GRAVITY
Repair System Description: CONVENTIONAL GRAVITY
Maintenance Agreement Required: ☐ Yes ☒ No
☐ Slab ☒ Crawl Space ☐ Basement w/plumbing ☐ Basement wo/plumbing


☐ House/Mod. Home ☒ Mobile Home ☐ Business ☐ Other
No. Bedrooms 3 No. Bathrooms 2 No. Employees ____

Water Supply: ☒ Individual ☐ Public ☐ Community
WELL

Comments/Conditions: KEEP SYSTEM MAXIMUM FEASIBLE DISTANCE FROM WELL (75')

Comments/Conditions: SEPTIC TANK W/ RISER INSTALLED USING "POLYLOK" FILTER

INITIAL SITE SKETCH

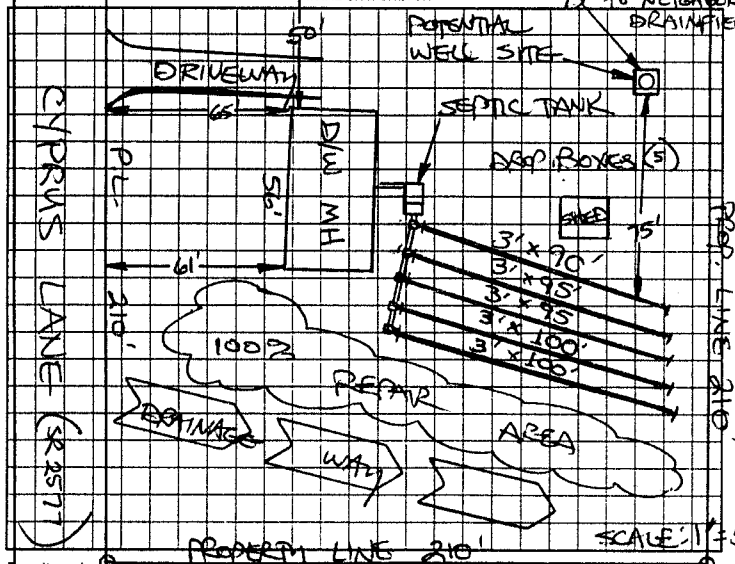

AS BUILT SKETCH

SYSTEM INSTALLED ACCORDING TO INITIAL SITE SKETCH

Permit can be suspended or revoked if any false information is supplied toward securing the permit/any unauthorized changes are made to the site/any unauthorized changes are made in the installation of the system. Improvement Permit with plat valid without expiration. Improvement Permit with site plan valid for sixty months. Authorization to Construct is valid for a period equal to that of Improvement Permit – not to exceed sixty months.

Signed: X Joseph C Dwyer Jr date 2-12-02 Installed by: JAMES HUNTER

Improvement Permit by: STEVE HEDRICK date 2-12-02 Operation Permit by: STEVE HEDRICK date 4-8-02

Authorization to Construct by: STEVE HEDRICK date 2-12-02 Existing System Inspection by: ____ date ____

HEALTH DEPT. COPY: WHITE OWNER COPY (FINAL) YELLOW OWNER COPY (INITIAL) PINK