2:00

IREDELL COUNTY HEALTH DEPARTMENT

STATESVILLE 704-878-5305 (F) MOORESVILLE 704-664-5281

IMPROVEMENT PERMIT / AUTHORIZATION TO CONSTRUCT / OPERATION PERMIT / EXISTING SYSTEM INSPECTION

PERMIT# 139556 PIN# 4762669971 DATE 8 January 07

OWNER OR APPLICANT Julia Carter / Rodney Mahoney PHONE: Business (704) 630-6400 Home

ADDRESS 1606 Jake Alexander Blvd. Salisbury, N.C. 28147

LOCATION 266 Log Cabin Rd. Statesville, N.C. 28677

SUBDIVISION Pine Tree Farms BLOCK / SECTION LOT #5 LOT AREA 0.806 Ac. SITE CLASS. PS DESIGN FLOW 360 g/d L.T.A.R. 0.3 g/Ft²/d

Septic Tank: 1000 Gallons; STB 825 Date 11-15-06

Pump Tank: Gallons; PT Date

Pump Make: Model Serial No.

Nitrification Field: No Fields 1 Square Feet = 1200 Linear Feet 300

No Lines 4 Trench Width 36" Max Trench Bottom Depth 36"

☑ New System ☐ Repair ☐ Expansion System Type: I (II) III IV V VI

System Description: 25% Reduction

Repair System Description: 50% Reduction

Maintenance Agreement Required: ☐ Yes ☒ No

☑ House/Mod. Home ☐ Mobile Home ☐ Business ☐ Other

No. Bedrooms 3 No. Persons No. Employees

Water Supply: ☑ Individual ☐ Public ☐ Community


Gravel Depth N/A ☑ Gravity ☐ Pressure ☐ Slab ☑ Crawl Space ☐ Basement w/plumbing ☐ Basement wo/plumbing

Comments:/Conditions: Follow contour /


Comments:/Conditions:

Blue Filter

INITIAL SITE SKETCH

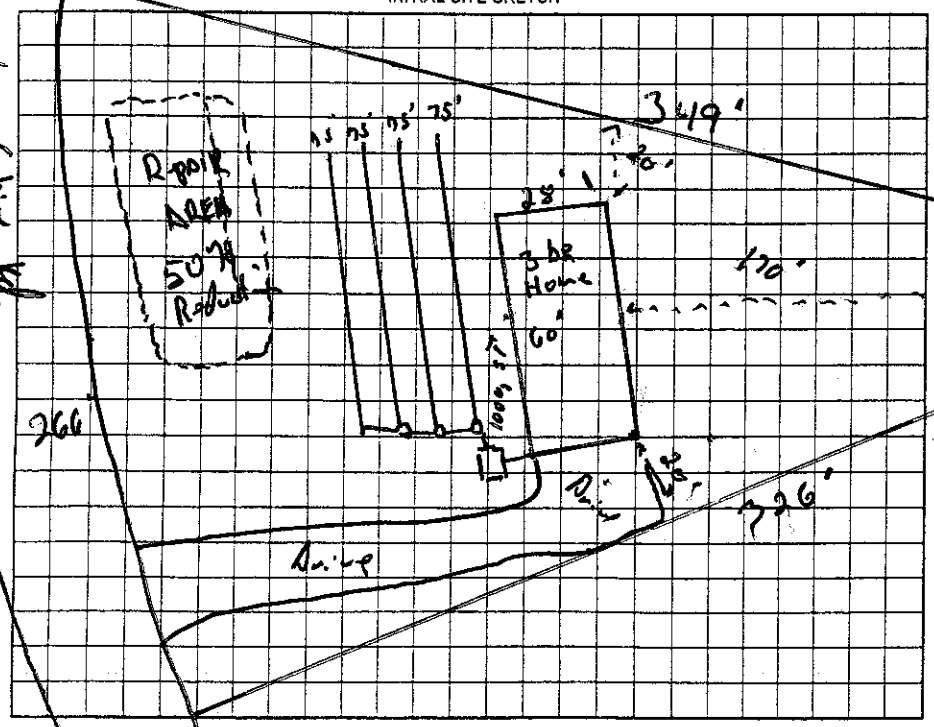

AS BUILT SKETCH

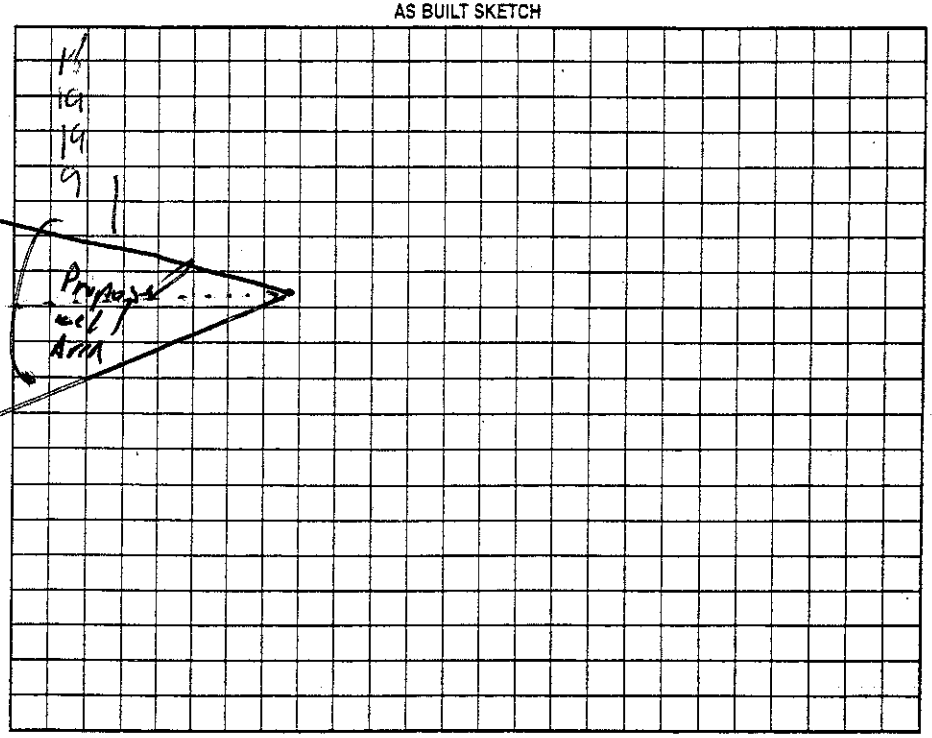

Permit can be suspended or revoked if any false information is supplied toward securing the permit/any unauthorized changes are made to the site/any unauthorized changes are made in the installation of the system. Improvement Permit with plat valid without expiration ☐ Improvement Permit with site plan valid for sixty months ☑ Authorization to Construct is valid for a period equal to that of Improvement Permit – not to exceed sixty months.

Signed: Julia Carter date 1/24/07 Installed by: Rowan Septic

Improvement Permit by: R.S. date 23 Jan. 07 Operation Permit by: date 2-6-07

Authorization to Construct by: R.S. date 23 Jan. 07 Existing System Inspection by: date

HEALTH DEPT. COPY: WHITE OWNER COPY (FINAL): YELLOW OWNER COPY (INITIAL): PINK