IREDELL COUNTY HEALTH DEPARTMENT

STATESVILLE 704-878-5305 MOORESVILLE 704-664-5281

IMPROVEMENT PERMIT / CERTIFICATE OF COMPLETION / OPERATION PERMIT / EXISTING SYSTEM INSPECTION

PROPERTY DESCRIPTION NO. ~~5J-4-A-7~~ 19292 DATE 9-1-94 TAX MAP NO. 5J-4-A-7 Watershed: ☐ Yes ☑ No

OWNER OR CONTRACTOR Carl E. Rochester PHONE: Business _____ Home 873-6470

ADDRESS 223 Log Cabin Circle Sta

LOCATION 70 E TR Bethesda TL Cornflower TR Pinetree at end TR 1/4mi Rt

SUBDIVISION Pine Tree Farms BLOCK / SECTION _____ LOT 24 LOT AREA 2 acres SITE CLASS. PS DESIGN FLOW 240 L.T.A.R. .2N

Septic Tank: 1000 Gallons: STB ~~1250~~ Date ~~4-29-92~~

Pump Tank: _____ Gallons: PT 1015 Date 6-25-94

Pump Make: _____ Model _____ Serial No. _____

Nitrification Field: No Fields 1 Square Feet 900 Linear Feet 300

No Lines 5 Trench Width 36" Max Trench Bottom Depth 24" Gravel Depth 12"

☑ New System ☐ Repair System Type: I ☑ II III IV V VI

System Description: Conv. Gravity

Repair System Description: Pump to Conv. lines

Maintenance Agreement Required: ☐ Yes ☑ No

☐ Slab ☑ Crawl Space ☐ Basement w/plumbing ☐ Basement wo/plumbing

☐ House/Mod. Home No. Bedrooms 3

☑ Mobile Home No. Bathrooms 1

☐ Business No. Employees _____

☐ Other _____

Water Supply: ☑ Individual ☐ Community ☐ Public well next door

Comments:


Run ditches shallow

No deeper than 24"

Comments:

Original Tank Turned Down Replaced with New S.T.

INITIAL SITE SKETCH

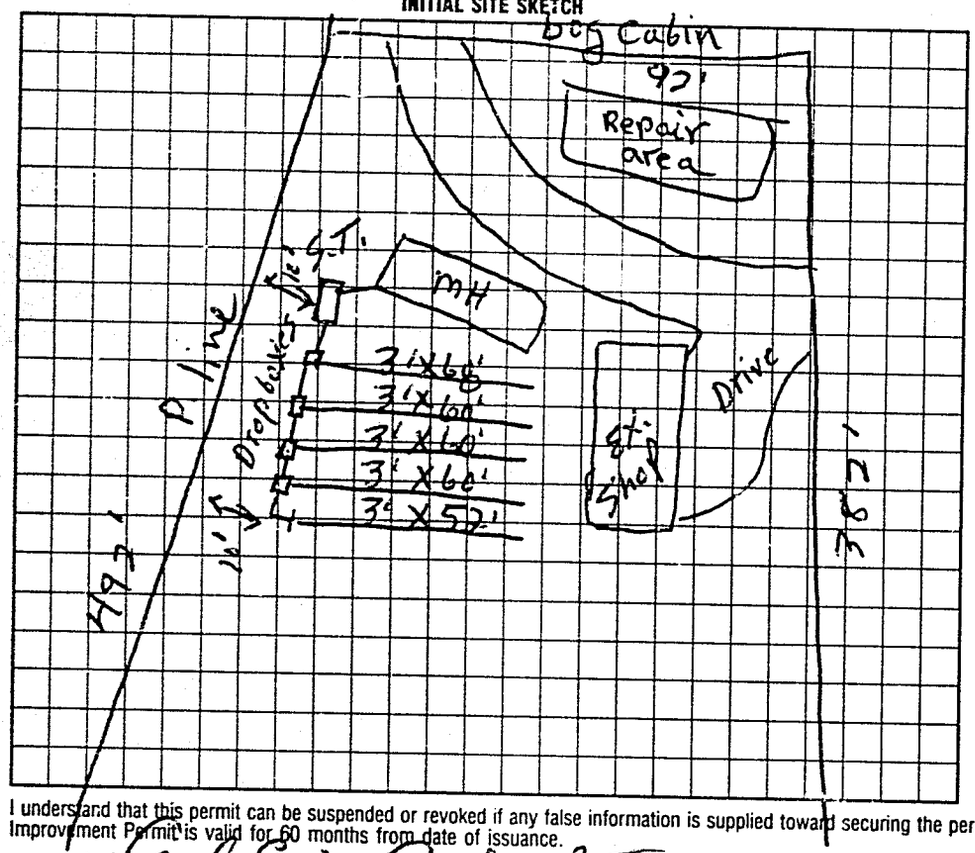

AS BUILT SKETCH

Same as initial sketch

I understand that this permit can be suspended or revoked if any false information is supplied toward securing the permit/any unauthorized changes are made to the site/any unauthorized changes are made in the installation of the system. Improvement Permit is valid for 60 months from date of issuance.

Signed: X Carl Eugene Rochester

Improvement Permit by: J. C. Moore date 9-1-94

Existing System Inspection by: _____ date _____

Installed by: J. C. Forsyth

Certificate of Completion by: J. C. Moore date 9-15-94

Operation Permit by: _____ date _____

HEALTH DEPT. COPY: WHITE INSPECTION COPY (FINAL): GREEN OWNER COPY (FINAL): YELLOW INSPECTION COPY (INITIAL): PINK OWNER COPY (INITIAL): GOLD

060200