IREDELL COUNTY HEALTH DEPARTMENT

Statesville Office (704) 878-5305 Mooresville Office (704) 660-3625 PERMIT # 216293

IMPROVEMENT PERMIT / AUTHORIZATION TO CONSTRUCT / OPERATION PERMIT / EXISTING SYSTEM

PIN # 4762 768 768

APPLICANT: Jessie + April Roberts APPLICANT ADDRESS: 173 Pine Tree Rd Statesville NC

SITE ADDRESS: 173 Pine Tree Rd Statesville NC PHONE: 704-657-0993 ALT. PHONE: 704-239-3693

SITE DIRECTIONS: 70E T/R Bethesda T/L Cornflower T/R Pine Tree Property on left

SUBDIVISION: N/A SECTION: N/A LOT # N/A LOT AREA: 2.41 ac DESIGN FLOW: 360 L.T.A.R.: 0.25

Septic Tank 1000 (gal) STB 760-1000 Date 3-15
Pump Tank (gal) PT Date
Pump Make Model Serial #
Nitrification Fields 1 # Lines 3 Linear Ft: 360
Trench Width 36" Max. Trench Bottom Depth 24" Gravel Depth N/A


[X] New System [ ] Repair [ ] Expansion System Type: I II [III] IV V VI
System Description: 25% Reduction
Repair System Description: Drip
Maintenance Agreement Required: [ ] YES [X] NO
[X] GRAVITY [ ] PRESSURE

[X] Residence No. Bedrooms 3
[ ] Business No. Persons 6
[ ] Other No. Employees
[ ] Slab [X] Crawl Space
[ ] Basement w/plumbing [ ] Basement w/o plumbing


Water Supply: [X] Private [ ] Public [ ] Community

Comments / Conditions:
1. Install 25% reduction on contour with serial distribution
2. Pump, crush + fill existing tank

INITIAL SITE SKETCH

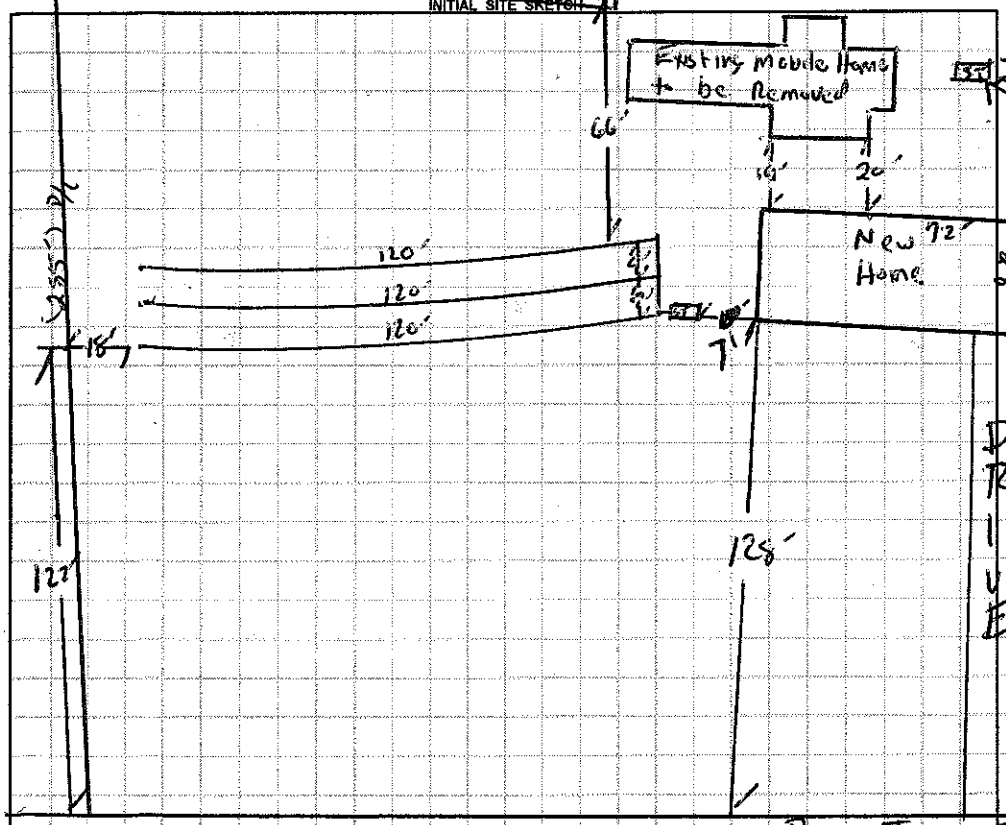

AS BUILT SKETCH

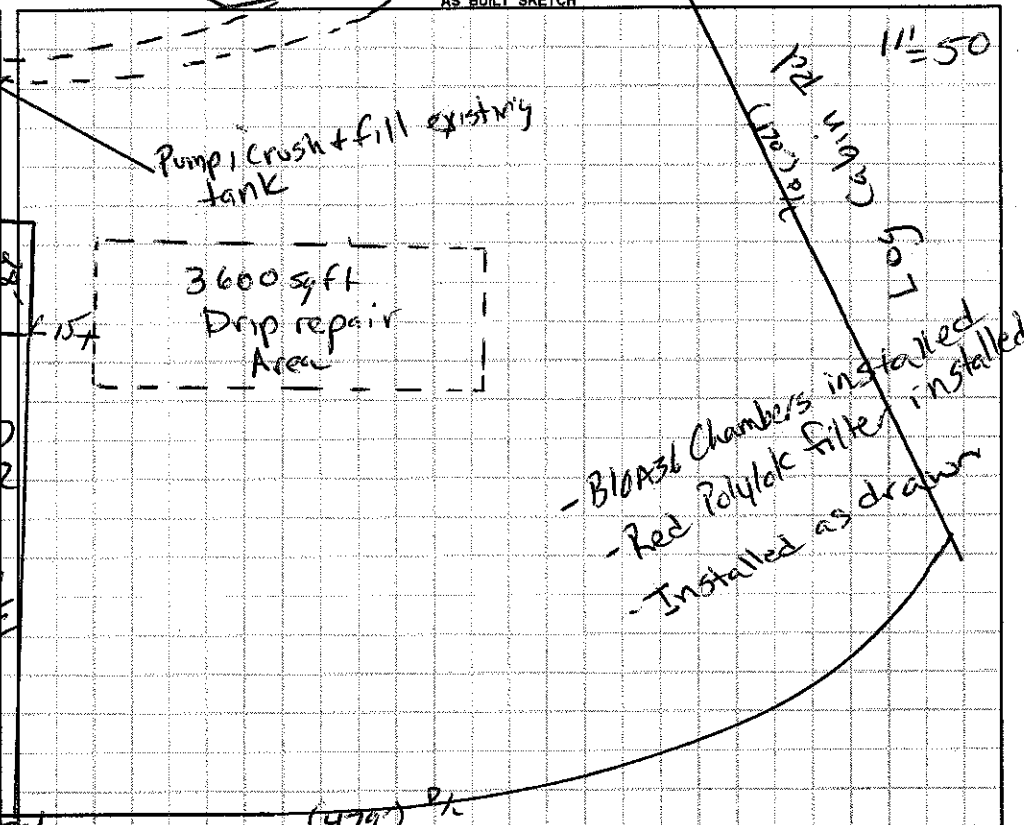

Permit can be suspended or revoked if any false information is supplied toward securing the permit / any unauthorized changes are made to the site / any unauthorized changes are made in the installation of the system. **CONTACT A LOCATOR SERVICE PRIOR TO ANY EXCAVATION**

[ ] **IMPROVEMENT PERMIT** *with plan valid without expiration.* [X] **IMPROVEMENT PERMIT** *with site plan valid for 60 mos.* [X] **AUTHORIZATION TO CONSTRUCT** *valid for period equal to IMPROVEMENT PERMIT--not to exceed 60 mo.*

Owner / Applicant Signature: Date: 3/3/16 Installed by: Tim Abee

IMPROVEMENT PERMIT by: Date: 03/02/16 OPERATION PERMIT by: Date: 06/20/16

AUTHORIZATION TO CONSTRUCT by: Date: 03/02/16 Existing System Inspected by: Date:

Health Dept. Copy - WHITE Applicant (Final Approval) - YELLOW Applicant (Conditional Approval) - PINK