IREDELL COUNTY HEALTH DEPARTMENT

STATESVILLE 704-878-5305 MOORESVILLE 704-664-5281

IMPROVEMENT PERMIT / CERTIFICATE OF COMPLETION / OPERATION PERMIT / EXISTING SYSTEM INSPECTION

PROPERTY DESCRIPTION NO. 68,696 DATE 8-26-97 TAX MAP NO. 4762770170 P.T. Watershed: ☐ Yes ☐ No

OWNER OR CONTRACTOR Ethel Cheek PHONE: Business _____ Home 873 5310

ADDRESS 280 Log Cabin Rd Sta.

LOCATION 70 E IR Bethania TL Cornflower TR Pine Tree TR Log Cabin 1/8mi left

SUBDIVISION Pine Tree Fm BLOCK / SECTION _____ LOT 86 LOT AREA 1.93 acres SITE CLASS. PS DESIGN FLOW 240 L.T.A.R. 1.2

Septic Tank: 1000 Gallons; STB 1004 Date 8-11-97
Pump Tank: _____ Gallons; PT _____ Date _____
Pump Make: _____ Model _____ Serial No. _____
Nitrification Field: No Fields 1 Square Feet 840 Linear Feet 280
No Lines 4 Trench Width 36" Max Trench Bottom Depth 24" Gravel Depth 12"

☑ New System ☐ Repair System Type: I II III IV V VI
System Description: Conv. Gravity
Repair System Description: " "
Maintenance Agreement Required: ☐ Yes ☐ No


☐ House/Mod. Home No. Bedrooms 2
☐ Mobile Home No. Bathrooms 2
☐ Business No. Employees _____
☐ Other _____
☐ Slab ☐ Crawl Space ☐ Basement w/plumbing ☐ Basement wo/plumbing

Water Supply:
☑ Individual
☐ Community
☐ Public


Comments: 378

Comments: Same initial Sketch

INITIAL SITE SKETCH

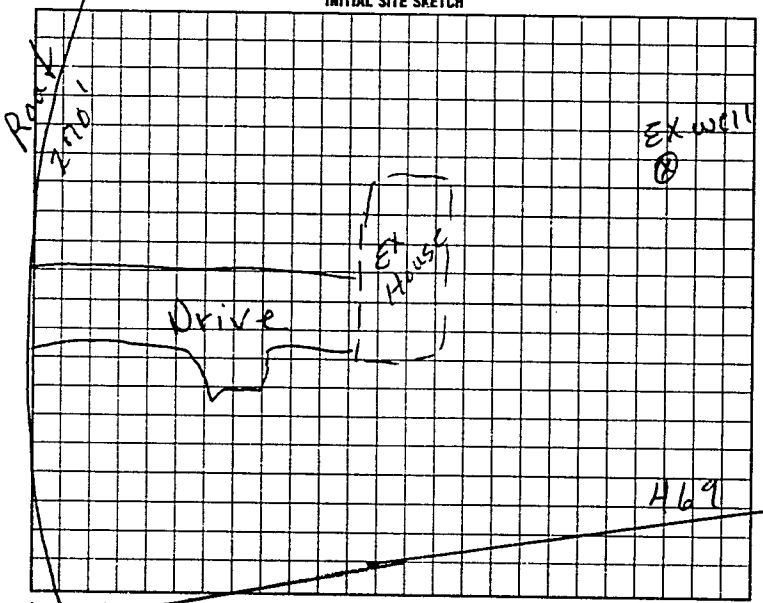

AS BUILT SKETCH

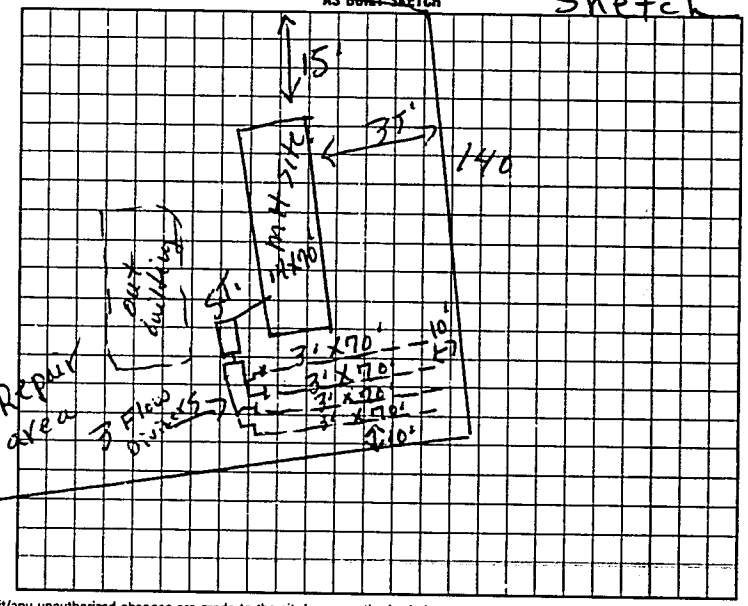

I understand that this permit can be suspended or revoked if any false information is supplied toward securing the permit/any unauthorized changes are made to the site/any unauthorized changes are made in the installation of the system. Improvement Permit is valid for 60 months from date of issuance.

Signed: X Ethel Cheek

Improvement Permit by: L.C. Moore date 8-26-97

Existing System Inspection by: L.C. Moore date 8-26-97

Installed by: Andy Daniels

Certificate of Completion by: _____ date _____

Operation Permit by: L.C. Moore date 9-19-97

HEALTH DEPT. COPY: WHITE INSPECTION COPY (FINAL): GREEN OWNER COPY (FINAL): YELLOW INSPECTION COPY (INITIAL): PINK OWNER COPY (INITIAL): GOLD

Authorization to count.

Authorization to count. Expires 60 mos from issue

6 1 3 0 0 0