IREDELL COUNTY HEALTH DEPARTMENT

STATESVILLE 704-878-5305 MOORESVILLE 704-664-5281

IMPROVEMENT PERMIT / CERTIFICATE OF COMPLETION / OPERATION PERMIT / EXISTING SYSTEM INSPECTION

PROPERTY DESCRIPTION NO. 065756 DATE 4-22-97 TAX MAP NO. 4762-77 0706 Watershed: ☐ Yes ☑ No

OWNER OR CONTRACTOR William S. Paulson PHONE: Business _____ Home 704-872-7995

ADDRESS 157 Cyprus Lane Statesville

LOCATION 70E TR Bethesta TL Cornflower TR Pine Tree TR Cyprus 1/10 left

SUBDIVISION Pine Tree BLOCK / SECTION _____ LOT 34 LOT AREA 210'X210' SITE CLASS. P5 DESIGN FLOW 360 L.T.A.R. .3

Septic Tank: 1000 Gallons; STB 1017 Date 3-3-97
Pump Tank: _____ Gallons; PT _____ Date _____
Pump Make: _____ Model _____ Serial No. _____
Nitrification Field: No Fields 1 Square Feet 1200 Linear Feet 400
No Lines 3 Trench Width 36" Max Trench Bottom Depth 36" Gravel Depth 12"

☑ New System ☐ Repair System Type: I, II, III, IV, V, VI
System Description: Conv. Gravity
Repair System Description: _____
Maintenance Agreement Required: ☐ Yes ☐ No

☐ House/Mod. Home No. Bedrooms 3
☑ Mobile Home No. Bathrooms 2
☐ Business No. Employees _____
☐ Other _____


☐ Slab ☑ Crawl Space ☐ Basement w/plumbing ☐ Basement w/o plumbing

Water Supply:
☑ Individual
☐ Community
☐ Public

Comments:

Comments:

INITIAL SITE SKETCH

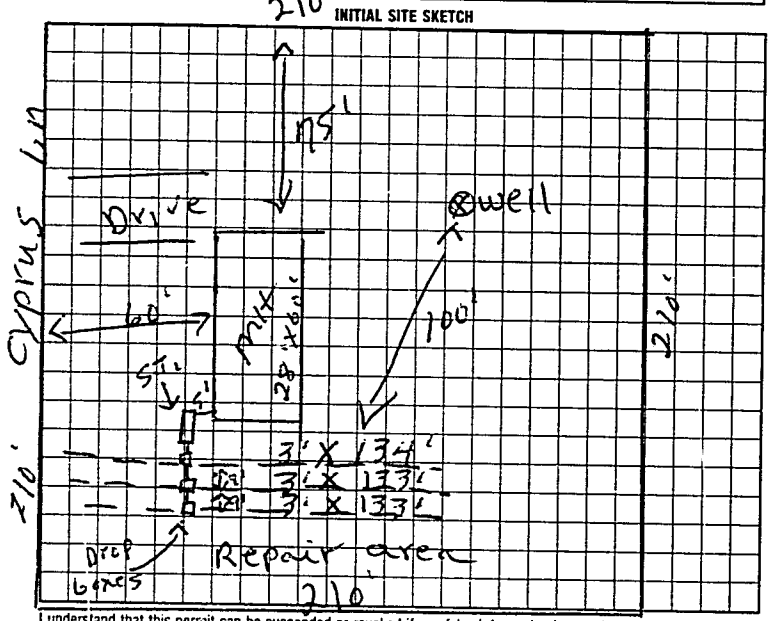

AS BUILT SKETCH

Same as initial sketch

I understand that this permit can be suspended or revoked if any false information is supplied toward securing the permit/any unauthorized changes are made to the site/any unauthorized changes are made in the installation of the system. Improvement Permit is valid for 60 months from date of issuance.

Signed: William Scott Paulson

Improvement Permit by: L.C. Moore date 4-22-97

Authorization to Construct by: L.C. Moore date 4-22-97

Existing System Inspection by: _____ date _____

Installed by: Donald Tarlton

Certificate of Completion by: L.C. Moore date _____

Operation Permit by: _____ date 5-7-97

WHITE: CONTRACTOR COPY — INSPECTION COPY (FINAL): GREEN — OWNER COPY (FINAL): YELLOW — INSPECTION COPY (INITIAL): PINK — OWNER COPY (INITIAL): GOLD

Authorization to Const. Expires 60 mos From issue

6/1/200