IREDELL COUNTY HEALTH DEPARTMENT

STATESVILLE 704-878-5305 MOORESVILLE 704-664-5281

IMPROVEMENT PERMIT / AUTHORIZATION TO CONSTRUCT / OPERATION PERMIT / EXISTING SYSTEM INSPECTION

PERMIT# 111480 PIN# 4762-77-2505 DATE 03/14/03

OWNER OR CONTRACTOR TERESA NEWTON PHONE: Business 704-363-6964 Home

ADDRESS 299 LOG CABIN RD. STATESVILLE, NC 28677

LOCATION HWY 70 E, (R) BETHESDA, (L) CORNFLOWER, (R) PINETREE, (R) LOG CABIN RD, <0.1 MILES ON RIGHT @ BOX # 299,

SUBDIVISION PINE TREE FARMS BLOCK / SECTION LOT 48 LOT AREA 1.15 ACRES SITE CLASS. EXISTING DESIGN FLOW 360 GPD L.T.A.R. EXISTING

Septic Tank: EXISTING Gallons; STB Date

Pump Tank: Gallons; PT EXISTING Date

Pump Make: Model Serial No.

Nitrification Field: No Fields 1 Square Feet 675 Linear Feet 45'

No Lines BED Trench Width 15' Max Trench Bottom Depth Gravel Depth

☐ New System ☐ Repair System Type: I, II, III, IV, V, VI

System Description: EXISTING SYSTEM

Repair System Description: GRAVEL BED

Maintenance Agreement Required: ☐ Yes ☐ No

☐ House/Mod. Home No. Bedrooms 3

☒ Mobile Home No. Bathrooms 2

☐ Business No. Employees

☐ Other

☐ Slab ☒ Crawl Space ☐ Basement w/plumbing ☐ Basement wo/plumbing

Water Supply:
☒ Individual
☐ Public
☐ Community
EXISTING WELL

Comments:/Conditions:

Comments:/Conditions:


* EXISTING SYSTEM INSPECTION

INITIAL SITE SKETCH

NOT TO SCALE; N 1"=60'

LOG CABIN RD.

AS BUILT SKETCH

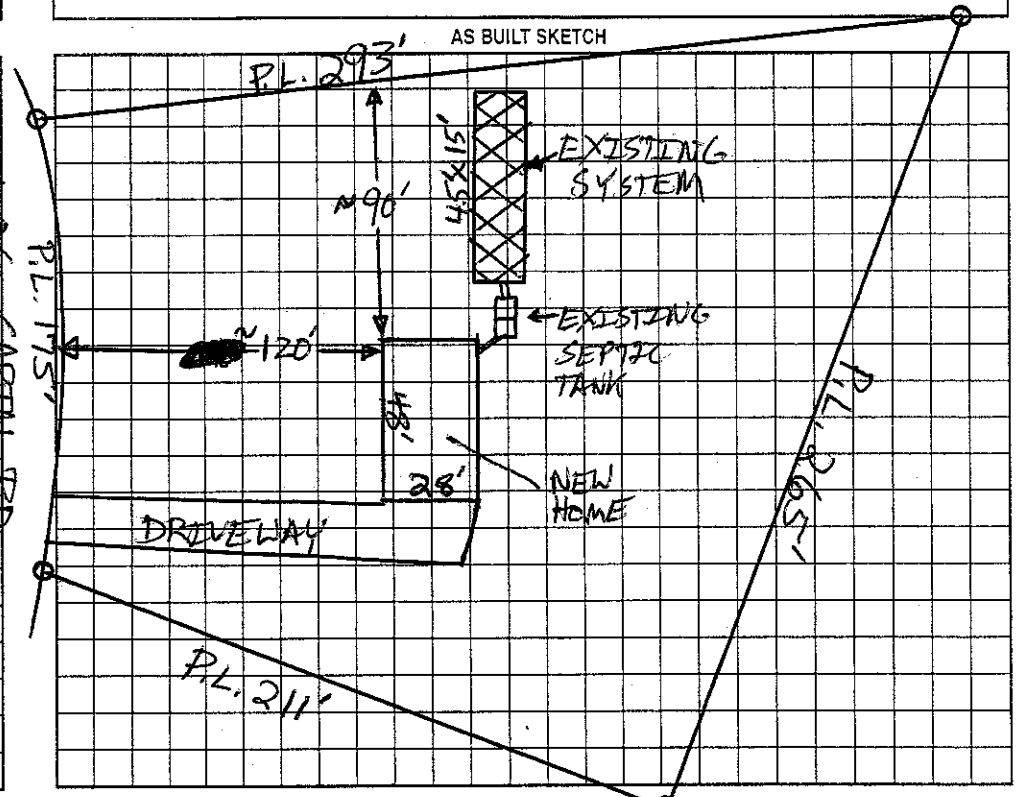

Permit can be suspended or revoked if any false information is supplied toward securing the permit/any unauthorized changes are made to the site/any unauthorized changes are made in the installation of the system. Improvement Permit with plat valid without expiration. Improvement Permit with site plan valid for sixty months. Authorization to Construct is valid for a period equal to that of Improvement Permit – not to exceed sixty months.

X Signed: date 3-14-03 Installed by:

Improvement Permit by: date Operation Permit by: date

Authorization to Construct by: date Existing System Inspection by: date 03/14/03

HEALTH DEPT. COPY: WHITE OWNER COPY (FINAL): YELLOW OWNER COPY (INITIAL): PINK