IREDELL COUNTY HEALTH DEPARTMENT

STATESVILLE 704-878-5305 MOORESVILLE 704-664-5281

IMPROVEMENT PERMIT / AUTHORIZATION TO CONSTRUCT / OPERATION PERMIT / EXISTING SYSTEM INSPECTION

PERMIT# 71812 PIN# 4762 77 2716 DATE 2-13-98

OWNER OR CONTRACTOR Daniel Paulson PHONE: Business Home 871 0304

ADDRESS 157 Cypress Lane Statesville, N.C.

LOCATION 70 E TR Bethesda TL Cornflower TR Pine Tree TR Cypress 3rd on (L)

SUBDIVISION Pine Tree BLOCK / SECTION LOT 35 LOT AREA 1.0 acre SITE CLASS. PS DESIGN FLOW 360 L.T.A.R. .27

Septic Tank: 1000 Gallons; STB 1012 Date 1-11-98

Pump Tank: Gallons; PT Date

Pump Make: Model Serial No.

Nitrification Field: No Fields 1 Square Feet 1350 Linear Feet 450

No Lines 3 Trench Width 36" Max Trench Bottom Depth 36" Gravel Depth 12"

☑ New System ☐ Repair System Type: I, II, III, IV, V, VI

System Description: conv. Gravity

Repair System Description: " "

Maintenance Agreement Required: ☐ Yes ☑ No

☐ House/Mod. Home No. Bedrooms 3

☑ Mobile Home No. Bathrooms 2

☐ Business No. Employees

☐ Other


☐ Slab ☑ Crawl Space ☐ Basement w/plumbing ☐ Basement wo/plumbing

Water Supply: ☑ Individual ☐ Public ☐ Community

Comments:/Conditions:

210'

INITIAL SITE SKETCH

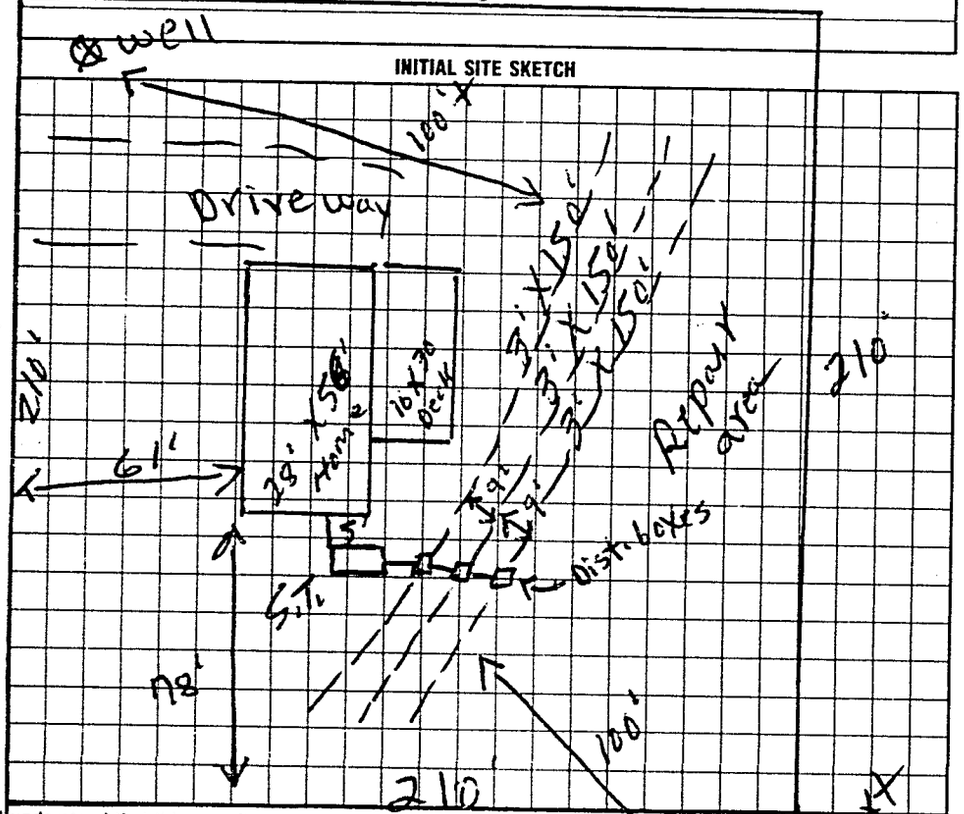

Comments:/Conditions:

AS BUILT SKETCH

Installed as shown

I understand that this permit can be suspended or revoked if any false information is supplied toward securing the permit/any unauthorized changes are made to the site/any unauthorized changes are made in the installation of the system. Improvement Permit with plat valid without expiration. Improvement Permit with site plan valid for sixty months. Authorization to Construct is valid for a period equal to that of Improvement Permit – not to exceed sixty months.

Signed: X Daniel J. Paulson date 2-13-98 Installed by: Rick Shook

Improvement Permit by: E.C. moore date 2-13-98 Operation Permit by: Mat Cauf RS date 3-30-98

Authorization to Construct by: E.C. moore date 2-13-98 Existing System Inspection by: date

HEALTH DEPT COPY WHITE INSPECTION COPY (FINAL) GREEN OWNER COPY (FINAL) YELLOW INSPECTION COPY (INITIAL) PINK OWNER COPY (INITIAL) GOLD

S 20500