IREDELL COUNTY HEALTH DEPARTMENT

STATESVILLE 704-878-5305 MOORESVILLE 704-664-5281

IMPROVEMENT PERMIT / CERTIFICATE OF COMPLETION / OPERATION PERMIT / EXISTING SYSTEM INSPECTION

PROPERTY DESCRIPTION NO. 18815 DATE 7-28-94 TAX MAP NO. 5J-4-A-57 Watershed: ☐ Yes ☑ No

OWNER OR CONTRACTOR Old Town mobile Home PHONE: Business 873 1481 Home 8

ADDRESS 2011e Northside Dr. Sta

LOCATION 70 E TR Bethela TR cornflower TR Pine Tree TR Lee Galin circle 2nd lot b.

SUBDIVISION Pine Tree BLOCK / SECTION LOT 57 LOT AREA 1 acre SITE CLASS. PS DESIGN FLOW 360 L.T.A.R. 1.3

Septic Tank: 1000 Gallons; STB 794 Date 6-24-94

Pump Tank: Gallons; PT Date

Pump Make: Model Serial No.

Nitrification Field: No Fields 1 Square Feet 1200 Linear Feet 400

No Lines 3 Trench Width 36" Max Trench Bottom Depth 24" Gravel Depth 12"

☑ New System ☐ Repair System Type: I, II, III, IV, V, VI

System Description: Conv. Gravity

Repair System Description:

Maintenance Agreement Required: ☐ Yes ☑ No

☐ House/Mod. Home ☑ Mobile Home ☐ Business ☐ Other

No. Bedrooms 3 No. Bathrooms 2 No. Employees


☐ Slab ☑ Crawl Space ☐ Basement w/plumbing ☐ Basement wo/plumbing

Water Supply: ☑ Individual ☐ Community ☐ Public

Comments:

Comments: Well located at time of inspection. 90' to Septic System. Home not located at time of inspection keep home min. 5' from [redacted] any part of septic system

INITIAL SITE SKETCH 210'

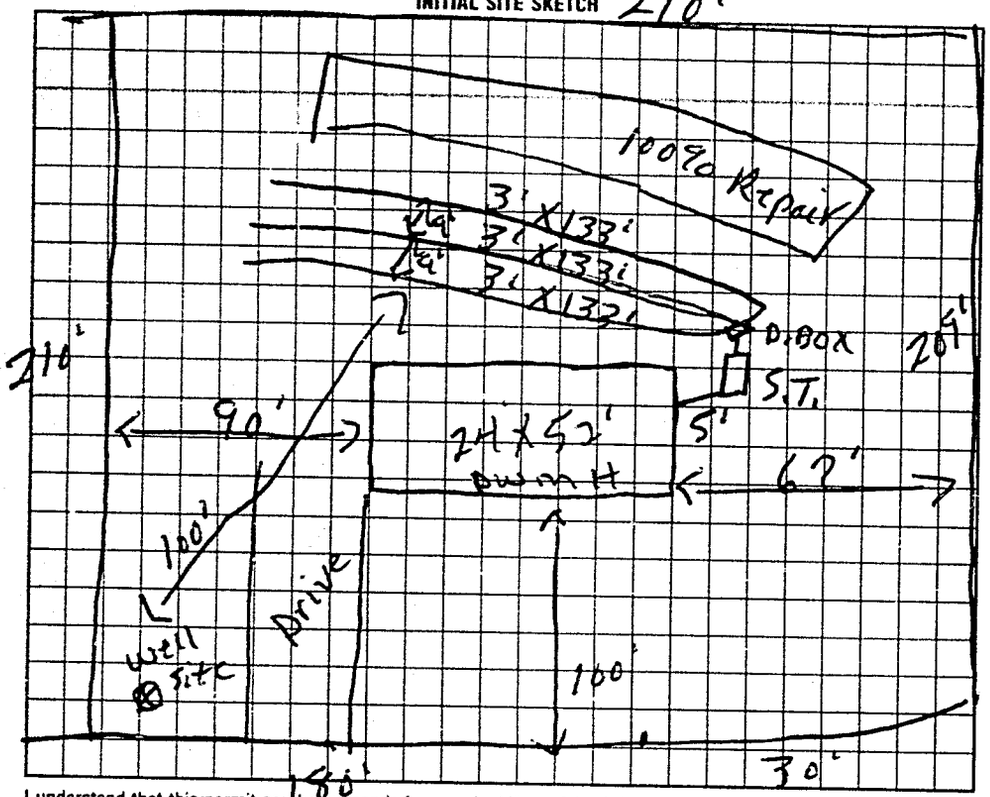

AS BUILT SKETCH

SAME AS INITIAL SKETCH

I understand that this permit can be suspended or revoked if any false information is supplied toward securing the permit/any unauthorized changes are made to the site/any unauthorized changes are made in the installation of the system. Improvement Permit is valid for 60 months from date of issuance.

Signed: [signature]

Improvement Permit by: E-C. moore date 7-28-94

Existing System Inspection by: date

Installed by: A-1 Backhoe

Certificate of Completion by: Michael J. Dennis date 10-11-94

Operation Permit by: date

HEALTH DEPT. COPY: WHITE INSPECTION COPY (FINAL): GREEN OWNER COPY (FINAL): YELLOW INSPECTION COPY (INITIAL): PINK OWNER COPY (INITIAL): GOLD