IREDELL COUNTY HEALTH DEPARTMENT

STATESVILLE 704-878-5305 MOORESVILLE 704-664-5281

IMPROVEMENT PERMIT / AUTHORIZATION TO CONSTRUCT / OPERATION PERMIT / EXISTING SYSTEM INSPECTI

PERMIT# 13410 PIN# 4762-78 0114 DATE 7-30-9

OWNER OR CONTRACTOR Fred Blake PHONE: Business Home

ADDRESS P.O. Box 46 Stoney Pt. N.C.

LOCATION 70 E TR Bethesda TL Corn Flaney TR Pine Tree TR Expres 1/

SUBDIVISION Pine Tree Fm BLOCK / SECTION LOT 5 LOT AREA 2.3 acres SITE CLASS PS DESIGN FLOW 360 L.T.A.R. .3

Septic Tank 1000 Gallons STB Scal Date 7-22-98

Pump Tank Gallons Pit Date

Pump Make Model Serial No

Nitrification Field: No Trnchs 1 Square Feet 1200 Linear Feet 400

No Lines 3 Trench Width 36" Max Trench Bottom Depth 36" Gravel Depth 12"

☑ New System ☐ Repair System Type: I ☑ II, IV, V, VI

System Description: Conv. Gravity

Repair System Description:

Maintenance Agreement Required: ☐ Yes ☑ No

☐ House/Mod. Home ☐ Mobile Home ☐ Business ☐ Other

No. Bedrooms 3 No. Bathrooms 2 No. Employees

☑ Water Sup ☐ Individ ☐ Public ☐ Comm


☐ Slab ☐ Crawl Space ☐ Basement w/plumbing ☐ Basement w/o plumbing

Comments/Conditions:


481

Comments:/Conditions:

INITIAL SITE SKETCH

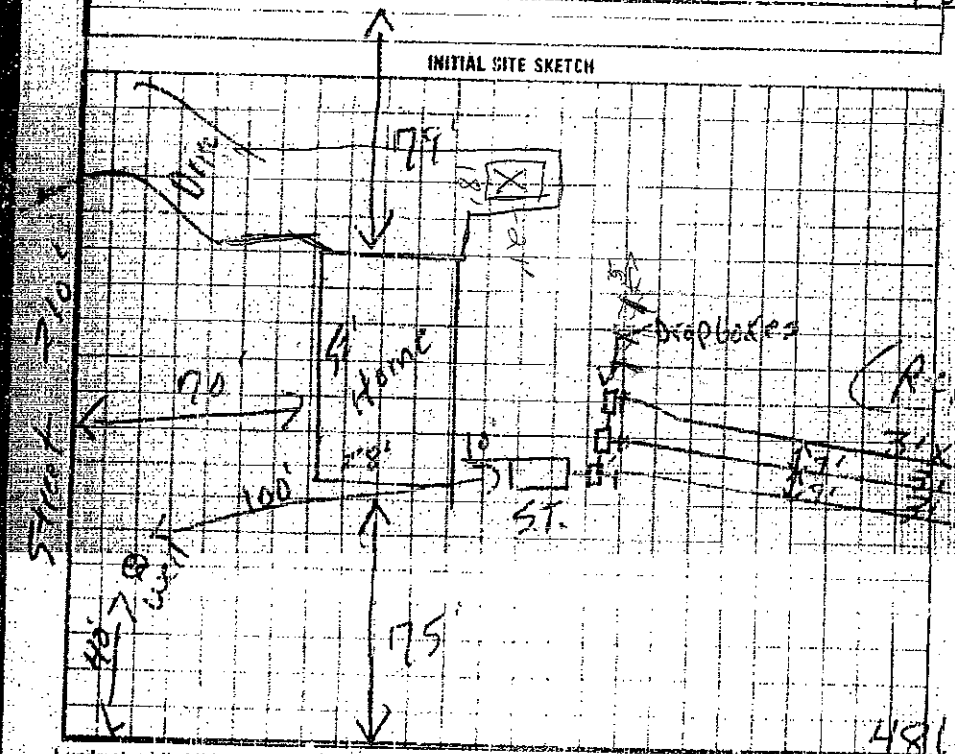

AS BUILT SKETCH

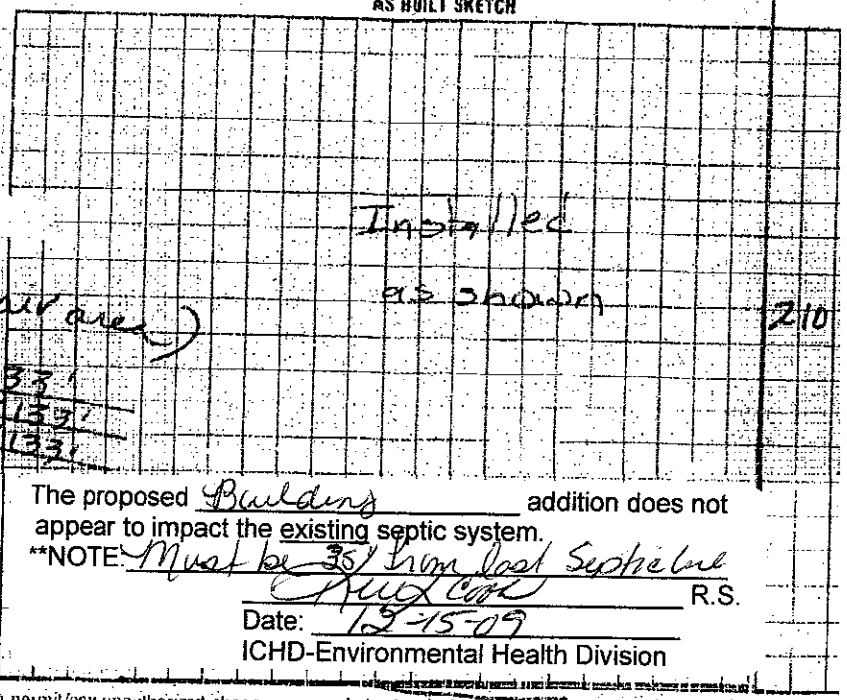

The proposed Building addition does not appear to impact the existing septic system.

**NOTE: Must be 35' from last Septic Line

R.S.

Date: 12-15-09

ICHD-Environmental Health Division

I understand that this permit can be suspended or revoked if any false information is supplied toward securing the permit/any unauthorized changes are made to the site/any unauthorized changes are made in the instal tion of the system. Improvement Permit with plat valid without expiration. Improvement Permit with site plan valid for sixty months. Authorization to Construct is valid for a period equal to that of Improvement Permit – to exceed sixty months.

Signed: X Fred Blake date

Improvement Permit by: P.C. Moore date 7-30-98

Authorization to Construct by: P.C. Moore date 7-30-98

Installed by: ACME Grading

Operation Permit by: M.H.C.O. RS date 9-9-98

JAN. 2, 1989 3:13