IREDELL COUNTY HEALTH DEPARTMENT

STATESVILLE 704-878-5305 MOORESVILLE 704-664-5281

#21358

IMPROVEMENT PERMIT / CERTIFICATE OF COMPLETION / OPERATION PERMIT / EXISTING SYSTEM INSPECTION

PROPERTY DESCRIPTION NO. 21358 DATE 6-19-95 TAX MAP NO. 5J-4-A-20 Watershed: ☐ Yes ☐ No

OWNER OR CONTRACTOR Richard Hill PHONE: Business _____ Home 873057

ADDRESS 805 Sugarcreek Rd

LOCATION NOE TR Bethesda TL Cornflower TR Pine Tree TR Cypress 1/8mi RT

SUBDIVISION Pine Tree Fm BLOCK / SECTION _____ LOT 20 LOT AREA 2.15 acres SITE CLASS. PS DESIGN FLOW 360 L.T.A.R. .3

Septic Tank: 1000 Gallons; STB 794 Date 11-6-96

Pump Tank: _____ Gallons; PT _____ Date _____

Pump Make: _____ Model _____ Serial No. _____

Nitrification Field: No Fields 1 Square Feet 1200 Linear Feet 400

No Lines 4 Trench Width 36" Max Trench Bottom Depth 36" Gravel Depth 12"

☑ New System ☐ Repair System Type: I (II) III, IV, V, VI

System Description: Conv-Gravity

Repair System Description: LL N

Maintenance Agreement Required: ☐ Yes ☑ No

☐ House/Mod. Home No. Bedrooms 3

☑ Mobile Home No. Bathrooms 1

☐ Business No. Employees _____

☐ Other _____

☐ Slab ☑ Crawl Space ☐ Basement w/plumbing ☐ Basement wo/plumbing

Water Supply: ☑ Individual ☐ Community ☐ Public


Comments:

Place drain lines 9' apart on center. Keep well 100' from S.T. System


Comments:

Well 88 ft from tank well in before system

INITIAL SITE SKETCH

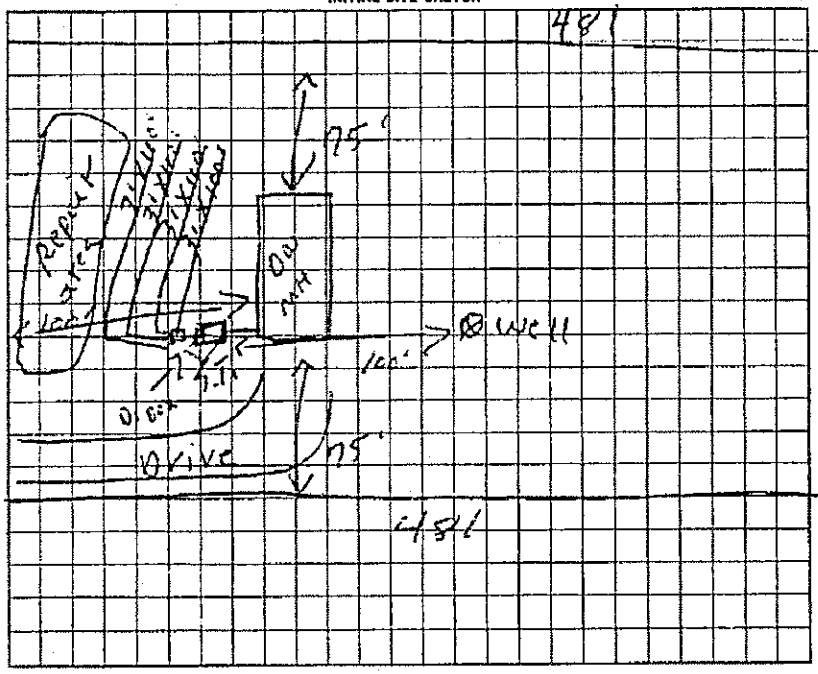

AS BUILT SKETCH

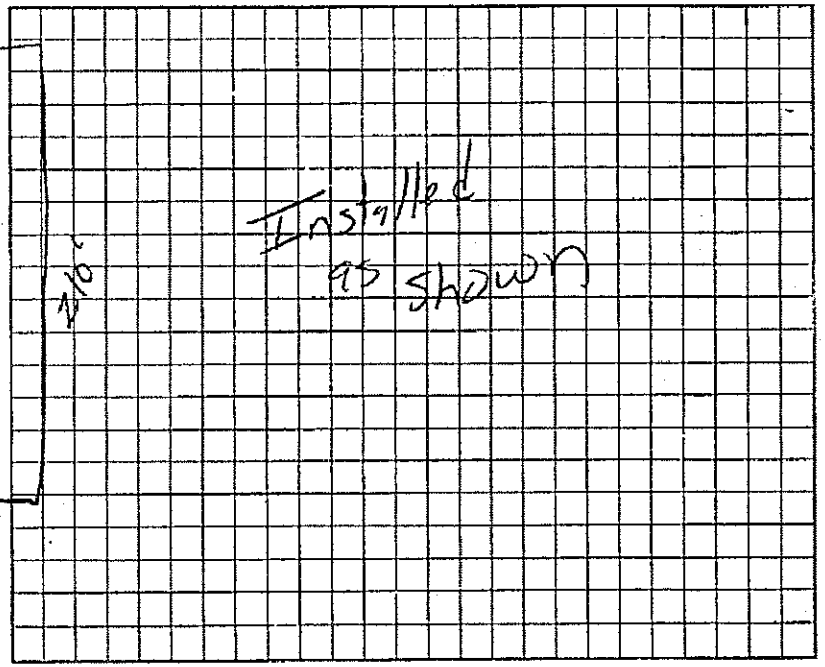

I understand that this permit can be suspended or revoked if any false information is supplied toward securing the permit/any unauthorized changes are made to the site/any unauthorized changes are made in the installation of the system. Improvement Permit is valid for 60 months from date of issuance.

Signed: x Tammy Hill

Improvement Permit by: P.C. Moore date 6-19-95

Existing System Inspection by: _____ date _____

Installed by: Don Innes

Certificate of Completion by: _____ date _____

Operation Permit by: Mark Coates date 1-28-97

HEALTH DEPT. COPY: WHITE INSPECTION COPY (FINAL): GREEN OWNER COPY (FINAL): YELLOW INSPECTION COPY (INITIAL): PINK OWNER COPY (INITIAL): GOLD

9840000