IREDELL COUNTY HEALTH DEPARTMENT

Statesville Office (704) 878-5305 Mooresville Office (704) 660-3625 PERMIT # 211858

IMPROVEMENT PERMIT / AUTHORIZATION TO CONSTRUCT / OPERATION PERMIT / EXISTING SYSTEM

PIN # 4762782006

APPLICANT: Michael Blake APPLICANT ADDRESS: 118 Cyprus Ln Statesville NC 28677

SITE ADDRESS: 118 Cyprus Ln Statesville NC 28677 PHONE: 828-455-6076 ALT. PHONE: N/A

SITE DIRECTIONS: I-77 S T/L Hwy 70 T/R Bethesda T/L Cornflower Rd T/R Pine tree rd T/R Cyprus Ln

SUBDIVISION: Pine Tree Farms SECTION: N/A LOT # PT 4 LOT AREA: 1.205 ac DESIGN FLOW: N/A L.T.A.R.: N/A

Septic Tank Ey (gal) STB Date

Pump Tank (gal) PT Date

Pump Make Model Serial #

Nitrification Fields Ey # Lines Ey Linear Ft: Ey

Trench Width Ey Max. Trench Bottom Depth Ey Gravel Depth Ey

☐ New System ☐ Repair ☐ Expansion System Type: I ☒ II III IV V VI

System Description: Existing

Repair System Description:

Maintenance Agreement Required: ☐ YES ☒ NO

☒ GRAVITY ☐ PRESSURE

☒ Residence No. Bedrooms Ey

☐ Business No. Persons Ey

☐ Other No. Employees


☐ Slab ☒ Crawl Space

☐ Basement w/plumbing ☐ Basement w/o plumbing

Water Supply: ☒ Private ☐ Public ☐ Community

Comments / Conditions: All building foundations must be 5' from any part of STS and >25' from any well.

INITIAL SITE SKETCH

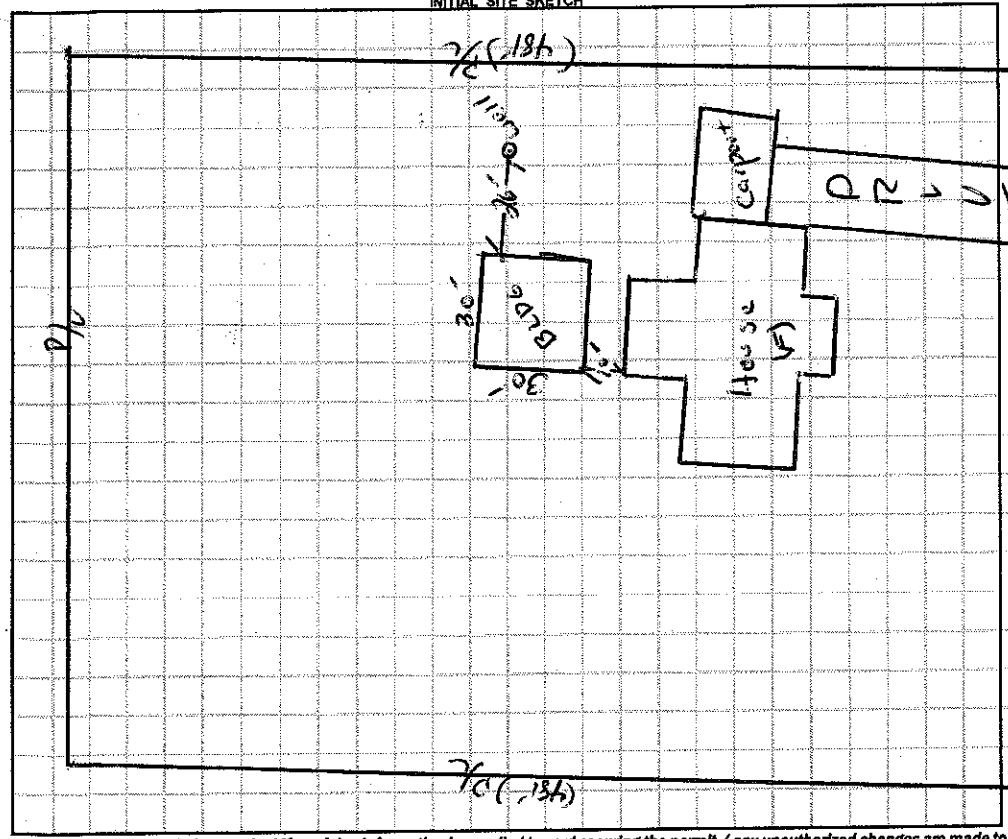

AS BUILT SKETCH

1" = 50'

Permit can be suspended or revoked if any false information is supplied toward securing the permit / any unauthorized changes are made to the site / any unauthorized changes are made in the installation of the system. CONTACT A LOCATOR SERVICE PRIOR TO ANY EXCAVATION

☐ IMPROVEMENT PERMIT *with plat* valid without expiration. ☐ IMPROVEMENT PERMIT *with site plan* valid for 60 mos. ☐ AUTHORIZATION TO CONSTRUCT valid for period equal to IMPROVEMENT PERMIT--not to exceed 60 mo.

Owner / Applicant Signature: Michael Blake Date: 7-31-15 Installed by:

IMPROVEMENT PERMIT by: Date: OPERATION PERMIT by: Date:

AUTHORIZATION TO CONSTRUCT by: Date: Existing System Inspected by: Date: 07/20/15

Health Dept. Copy - WHITE Applicant (Final Approval) - YELLOW Applicant (Conditional Approval) - PINK