IREDELL COUNTY HEALTH DEPARTMENT

STATESVILLE 704-878-5305 MOORESVILLE 704-664-5281

IMPROVEMENT PERMIT / CERTIFICATE OF COMPLETION / OPERATION PERMIT / EXISTING SYSTEM INSPECTION

PROPERTY DESCRIPTION NO. 24520 DATE 10-22-96 TAX MAP NO. 5F-A-1B Watershed: ☐ Yes ☑ No

OWNER OR CONTRACTOR John McCoy PHONE: Business Home 873 3874

ADDRESS 619 Bethesta Rd Statesville

LOCATION 70 E TR Bethesta TL Log Dr. 3/4mi

SUBDIVISION McCoy Campground BLOCK / SECTION LOT LOT AREA .043acres SITE CLASS. PS DESIGN FLOW 720 L.T.A.R. .33

Septic Tank: 1500 Gallons; STB 1011 Date 5-16-97 ☐ New System ☐ Repair System Type: I, II, III, IV, V, VI

Pump Tank: Gallons; PT Date System Description: Conv. Gravity

Pump Make: Model Serial No. Repair System Description: Pump to Conv. Lines

Nitrification Field: No Fields 1 Square Feet 2250 Linear Feet 1750 Maintenance Agreement Required: ☐ Yes ☑ No

No Lines 6 Trench Width 36" Max Trench Bottom Depth 24" Gravel Depth 12"

☐ House/Mod. Home No. Bedrooms

☐ Mobile Home No. Bathrooms

☐ Business No. Employees

☑ Other 6 camp sites


☐ Slab ☑ Crawl Space ☐ Basement w/plumbing ☐ Basement wo/plumbing

Water Supply: ☐ Individual ☑ Community ☐ Public


Comments:

Comments: As Shown

INITIAL SITE SKETCH

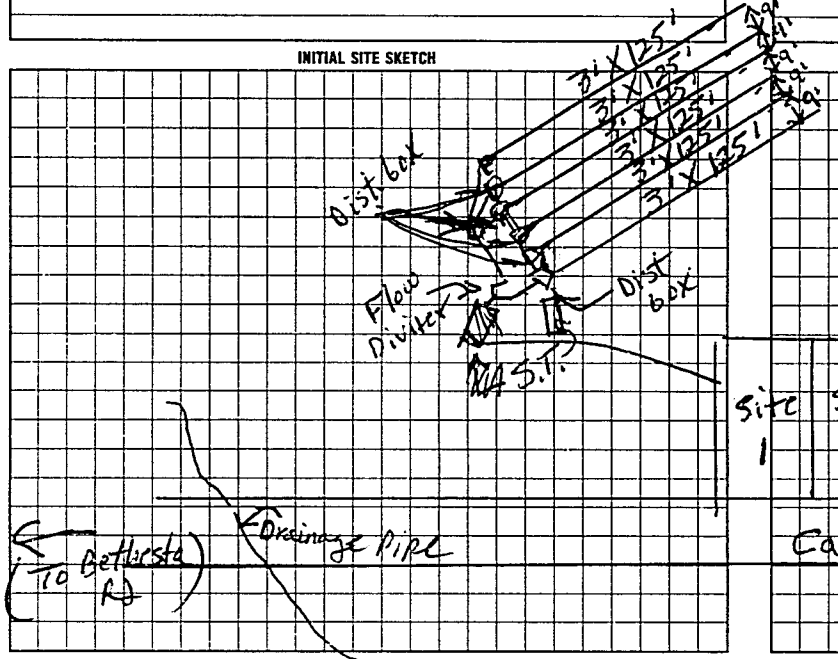

AS BUILT SKETCH

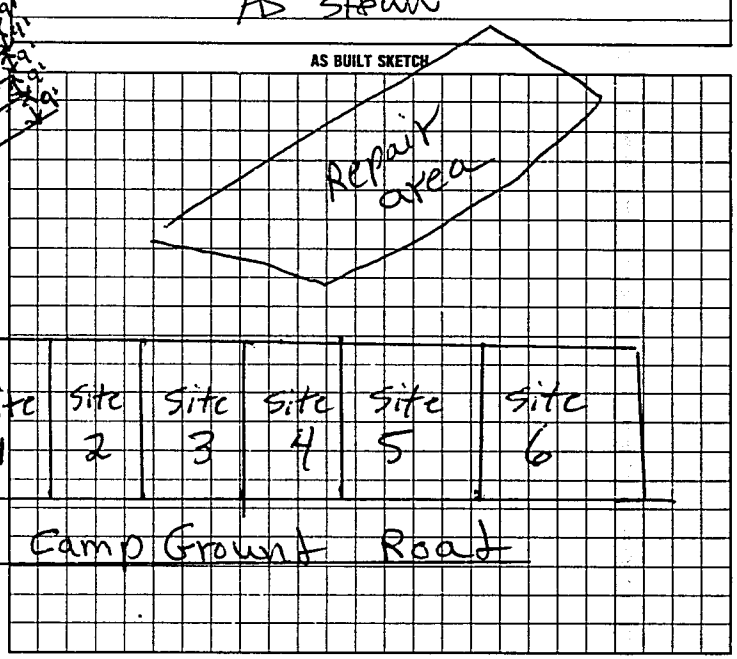

I understand that this permit can be suspended or revoked if any false information is supplied toward securing the permit/any unauthorized changes are made to the site/any unauthorized changes are made in the installation of the system.

Signed: Nettie N McCoy Installed by: TOMMY FRYE

Improvement Permit by: L.C. Moore date 10-22-96 Certificate of Completion by: date

Existing System Inspection by: L.C. Moore date 10-22-96 Operation Permit by: STEVE HENDRICK date 6-20-97

Authorization to Cover

HEALTH DEPT COPY: WHITE INSPECTION COPY (FINAL): GREEN OWNER COPY (FINAL): YELLOW INSPECTION COPY (INITIAL): PINK OWNER COPY (INITIAL): GOLD

Authorization to Cover Expires 60 mos from issue

708100