IREDELL COUNTY HEALTH DEPARTMENT

STATESVILLE 704-878-5305 MOORESVILLE 704-664-5281

IMPROVEMENT PERMIT / CERTIFICATE OF COMPLETION / OPERATION PERMIT / EXISTING SYSTEM INSPECTION

PROPERTY DESCRIPTION NO. 24520 DATE 10-22-96 TAX MAP NO. 5E-A-18 Watershed: ☐ Yes ☑ No

OWNER OR CONTRACTOR John McCoy PHONE: Business Home 873 3874

ADDRESS 619 Bethesda RD Statesville

LOCATION 70E TR Bethesda RD To Log Dr. 3/4 mi

SUBDIVISION McCoy Campground BLOCK / SECTION LOT LOT AREA 43 acres SITE CLASS. PS DESIGN FLOW 720 L.T.A.R. .133

Septic Tank: 1500 Gallons; STB 1011 Date 5-26-97

Pump Tank: Gallons; PT Date 5-25-97

Pump Make: Model Serial No.

Nitrification Field: No Fields 1 Square Feet 2250 Linear Feet 1750

No Lines 6 Trench Width 36" Max Trench Bottom Depth 24" Gravel Depth 12"

☑ New System ☐ Repair System Type: I, II, III, IV, V, VI

System Description: Conv. Gravity

Repair System Description: " Pump

Maintenance Agreement Required: ☐ Yes ☑ No

☐ House/Mod. Home No. Bedrooms

☐ Mobile Home No. Bathrooms

☐ Business No. Employees

☑ Other 6 camp sites


☐ Slab ☐ Crawl Space ☐ Basement w/plumbing ☐ Basement wo/plumbing

Water Supply: ☐ Individual ☑ Community ☐ Public


Comments: Repair area

Comments:

INITIAL SITE SKETCH

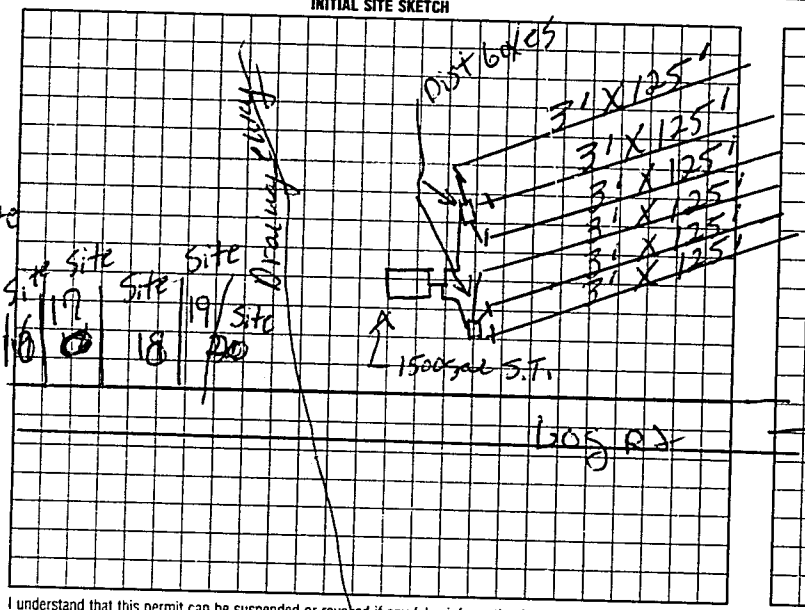

AS BUILT SKETCH

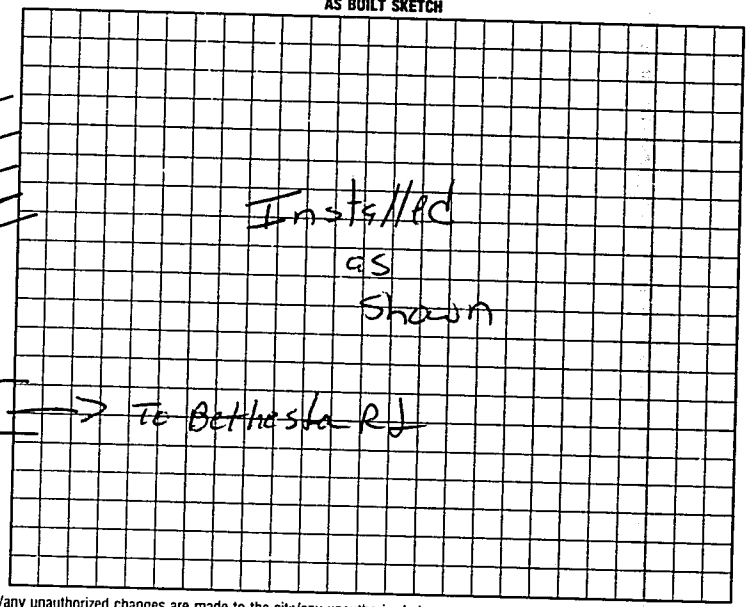

I understand that this permit can be suspended or revoked if any false information is supplied toward securing the permit/any unauthorized changes are made to the site/any unauthorized changes are made in the installation of the system.

Signed: Nettie H McCoy

Improvement Permit by: L.C. Moore date 10-22-96

Authorization to Count by: L.C. Moore date 10-22-96

Existing System Inspection by:

Installed by: Tommy Faye

Certificate of Completion by: date

Operation Permit by: Mat C Ost RS date 6-9-97

HEALTH DEPT COPY WHITE INSPECTION COPY (FINAL) GREEN OWNER COPY (FINAL) YELLOW INSPECTION COPY (INITIAL) PINK OWNER COPY (INITIAL) GOLD

Authorization to Count Existing 60 mor from 15 Site