IREDELL COUNTY HEALTH DEPARTMENT

STATESVILLE 704-878-5305 MOORESVILLE 704-664-5281

IMPROVEMENT PERMIT / CERTIFICATE OF COMPLETION / OPERATION PERMIT / EXISTING SYSTEM INSPECTION

PROPERTY DESCRIPTION NO. 24520 DATE 10-22-96 TAX MAP NO. 5E-A-1B Watershed: ☐ Yes ☑ No

OWNER OR CONTRACTOR John McCoy PHONE: Business _____ Home 873 3874

ADDRESS 619 Bethesta Rd Statesville

LOCATION 70E TR Bethesta Rd TL Log Dr. 3/4 mi

SUBDIVISION McCoy Campground BLOCK / SECTION _____ LOTS _____ LOT AREA .43acres SITE CLASS. PS DESIGN FLOW 960 L.T.A.R. .43

1000

Septic Tank: ~~1500~~ Gallons; STB 1012 Date 3-11-97

Pump Tank: 1000 Gallons; PT 17 Date 4-1-97

Pump Make: _____ Model _____ Serial No. _____

Nitrification Field: No Fields 1 Square Feet 2250 Linear Feet 750

No Lines 6 Trench Width 36" Max Trench Bottom Depth 36" Gravel Depth 12"

☑ New System ☐ Repair System Type: I, II, III, IV, V, VI

System Description: Conv. Gravity

Repair System Description: Pump To Conv lines

Maintenance Agreement Required: ☐ Yes ☑ No

☐ House/Mod. Home No. Bedrooms ____

☐ Mobile Home No. Bathrooms ____

☐ Business No. Employees ____

☑ Other 8 Camp Sites

☐ Slab ☑ Crawl Space ☐ Basement w/plumbing ☐ Basement wo/plumbing


Water Supply: ☐ Individual ☑ Community ☐ Public

Comments:


Use Two Tanks In Series
1st Tank 1000 gal Pump Tank
With Sch 40 Tee on outlet
Then Regular 1000 Gal ST.

Comments:

INITIAL SITE SKETCH

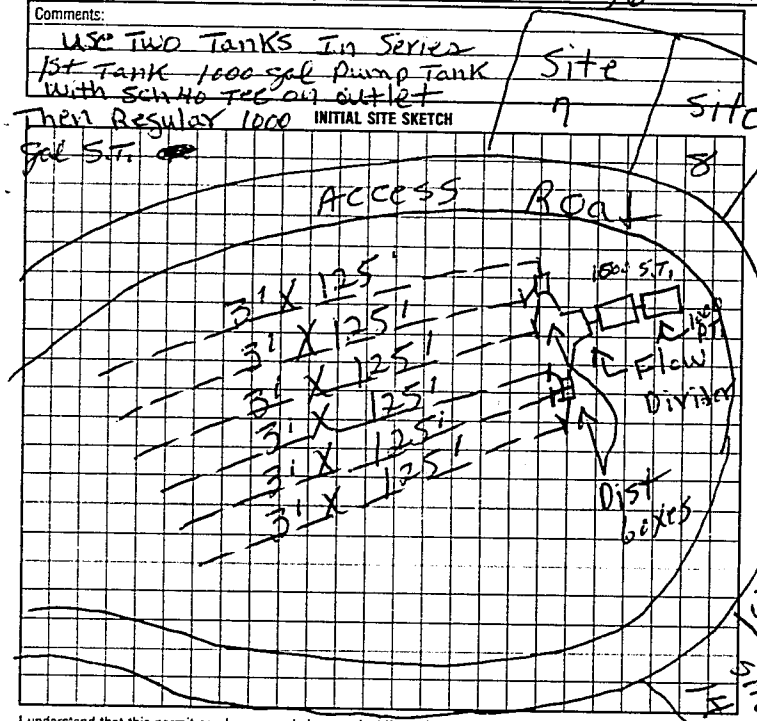

AS BUILT SKETCH

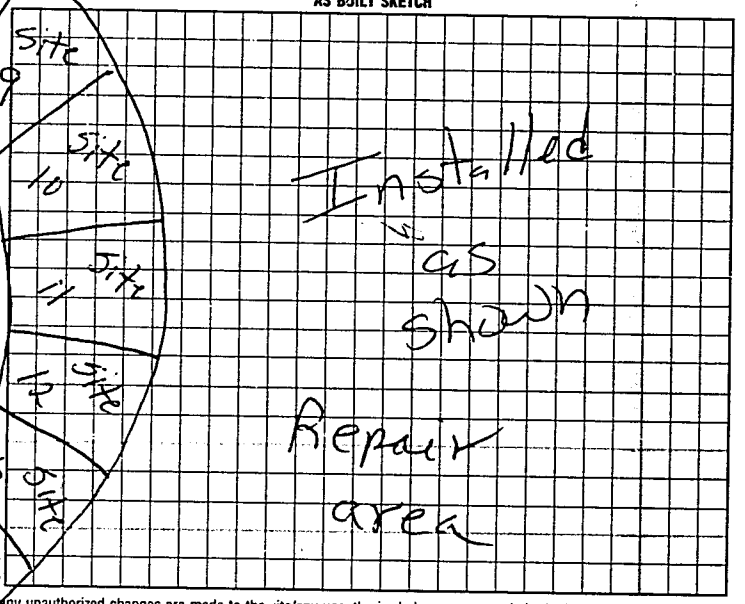

I understand that this permit can be suspended or revoked if any false information is supplied toward securing the permit, any unauthorized changes are made to the site/any unauthorized changes are made in the installation of the system.

Signed: Nettie H McCoy

Improvement Permit by: E.C. Moore date 10-22-96

Authorization to Construct by: E.C. Moore date 10-22-96

Installed by: Tommy Frye

Certificate of Completion by: _____ date _____

Operation Permit by: Mat C Off RS date 5-15-97

HEALTH DEPT. COPY: WHITE INSPECTION COPY (FINAL): GREEN OWNER COPY (FINAL): YELLOW INSPECTION COPY (INITIAL): PINK OWNER COPY (INITIAL): GOLD

Authorization to Const EXPIRES 60 mos from issue

608100