IREDELL COUNTY HEALTH DEPARTMENT

STATESVILLE 704-878-5305 MOORESVILLE 704-664-5281

IMPROVEMENT PERMIT / CERTIFICATE OF COMPLETION / OPERATION PERMIT / EXISTING SYSTEM INSPECTION

Watershed: ☐ Yes ☑ No

PROPERTY DESCRIPTION NO. 066167 DATE 5-13-97 TAX MAP NO. 4762862973

OWNER OR CONTRACTOR Michael Jines PHONE: Business Home 873 1557

ADDRESS 173 Log Cabin Rd

LOCATION 70E TR to Ethida TL Cornflower TR Log Cabin Rd 3rd lot Rt

SUBDIVISION Pine Tree Em BLOCK / SECTION LOT LOT AREA 1+ acres SITE CLASS PS DESIGN FLOW 360 L.T.A.R. .7

Septic Tank: 1000 Gallons; STB Date

Pump Tank: Gallons; PT Date

Pump Make: Model 300 Serial No.

Nitrification Field: No Fields 1 Square Feet 400 Linear Feet 400

No Lines 1 Trench Width 3'-11" Max Trench Bottom Depth 3'-11" Gravel Depth 12"

☐ New System ☐ Repair System Type: I, II, III, IV, V, VI

System Description: Replacement Conventional

Repair System Description:

Maintenance Agreement Required: ☐ Yes ☐ No

☐ House/Mod. Home ☐ Mobile Home ☐ Business ☐ Other

No. Bedrooms No. Bathrooms No. Employees


Water Supply: ☐ Individual ☐ Community ☐ Public

☐ Slab ☑ Crawl Space ☐ Basement w/plumbing ☐ Basement wo/plumbing


Comments: Replacing 2 Bedroom SWMH With 3 Bedroom DWMH System being brought up to 3 Bedroom Standard

Comments: System was Installed 8-20-85 Mike Jines Name on Permit.

INITIAL SITE SKETCH

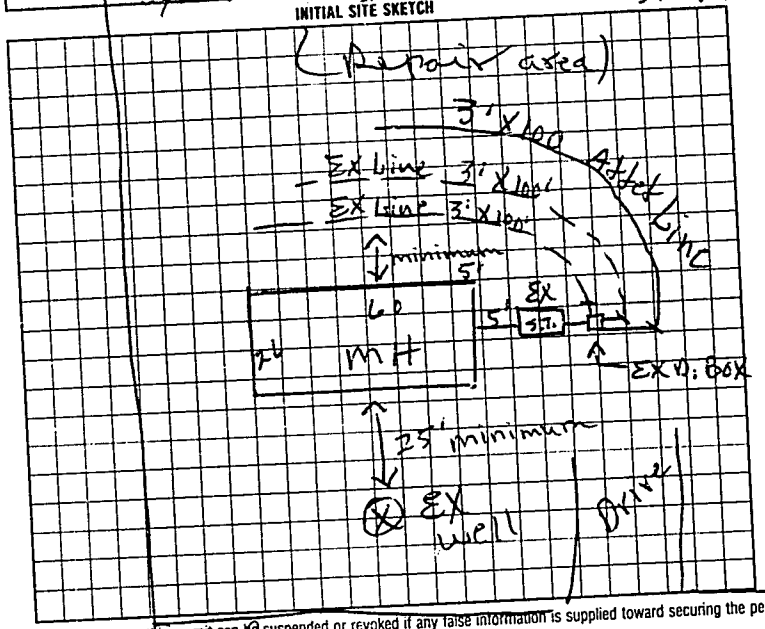

AS BUILT SKETCH

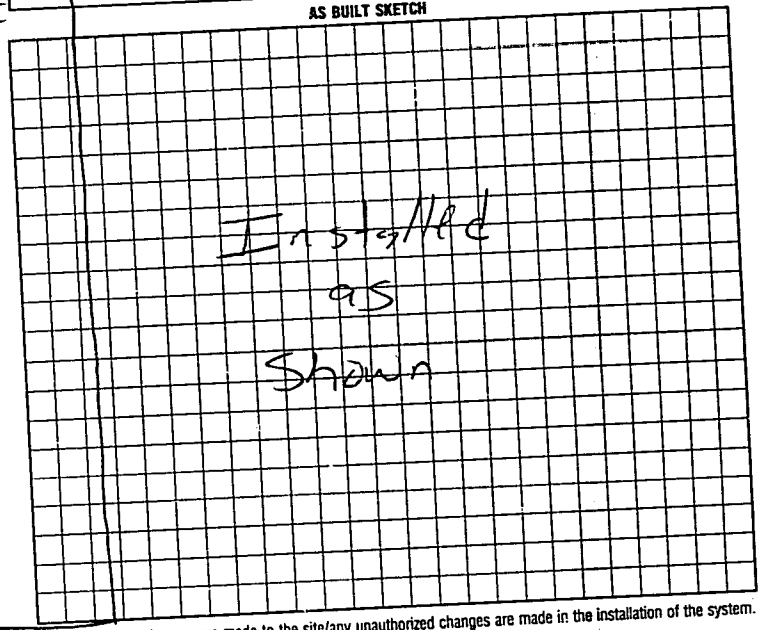

I understand that this permit can be suspended or revoked if any false information is supplied toward securing the permit/any unauthorized changes are made to the site/any unauthorized changes are made in the installation of the system. Improvement Permit is valid for 60 months from date of issuance.

Signed: X

Improvement Permit by: D.C. Moore date 5-13-97

Authorization to Install by: D.C. Moore date 5-13-97

Installed by: Donald Lackey date

Certificate of Completion by: Mark C.O.C 125 date 6-3-97

Operation Permit by: Authorization to Count Expires 60 months from issue

HEALTH DEPT. COPY: WHITE INSPECTION COPY (FINAL): GREEN OWNER COPY (FINAL): YELLOW INSPECTION COPY (INITIAL): PINK OWNER COPY (INITIAL): GOLD

0 0 1 1 0 0