IREDELL COUNTY HEALTH DEPARTMENT

STATESVILLE 704-878-5305 MOORESVILLE 704-664-5281

IMPROVEMENT PERMIT / AUTHORIZATION TO CONSTRUCT / OPERATION PERMIT / EXISTING SYSTEM INSPECTION

PERMIT# 86444 PIN# 4762876488 DATE 12-7-99

OWNER OR CONTRACTOR Larry White PHONE: Business 528 4810 Home

ADDRESS 137 PowderHorn Rd Mooresville N.C.

LOCATION 70E TR Bethesda TL Cornflower TR Log cabin 5th lot left

SUBDIVISION Pine Tree BLOCK / SECTION LOT 64 LOT AREA 1.0 acres SITE CLASS PS DESIGN FLOW 360 L.T.A.R. 13

Septic Tank: 1000 Gallons; STB 794 Date 5-12-00
Pump Tank: Gallons; PT Date
Pump Make: Model Serial No.
Nitrification Field: No Fields 1 Square Feet 1200 Linear Feet 400
No Lines 5 Trench Width 36" Max Trench Bottom Depth 36" Gravel Depth 12"

☑ New System ☐ Repair System Type: I, II, III, IV, V, VI
System Description: Conv. Gravity
Repair System Description: " "
Maintenance Agreement Required: ☐ Yes ☑ No
☐ Slab ☑ Crawl Space ☐ Basement w/plumbing ☐ Basement wo/plumbing


☐ House/Mod. Home No. Bedrooms 3
☑ Mobile Home No. Bathrooms 2
☐ Business No. Employees
☐ Other

Water Supply: ☑ Individual ☐ Public ☐ Community


Comments:/Conditions:

Comments:/Conditions: SEPTIC TANK W/ MARKER INSTALLED USING "BABEL" FILTER

INITIAL SITE SKETCH

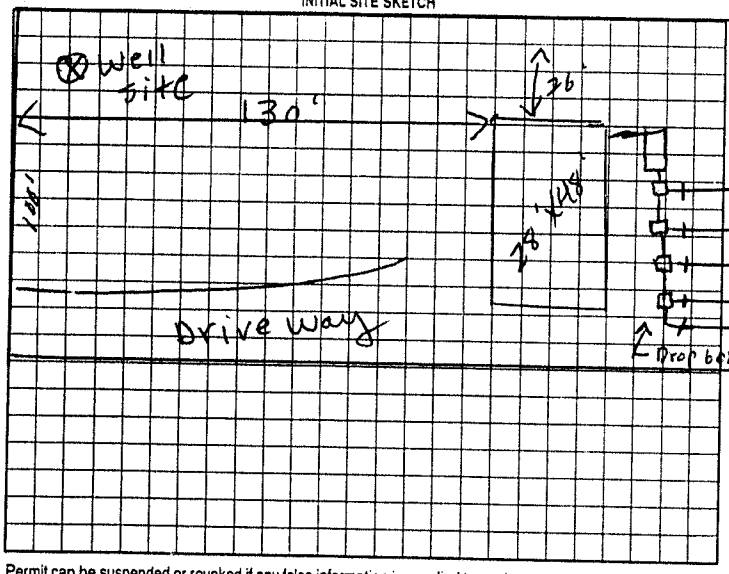

AS BUILT SKETCH

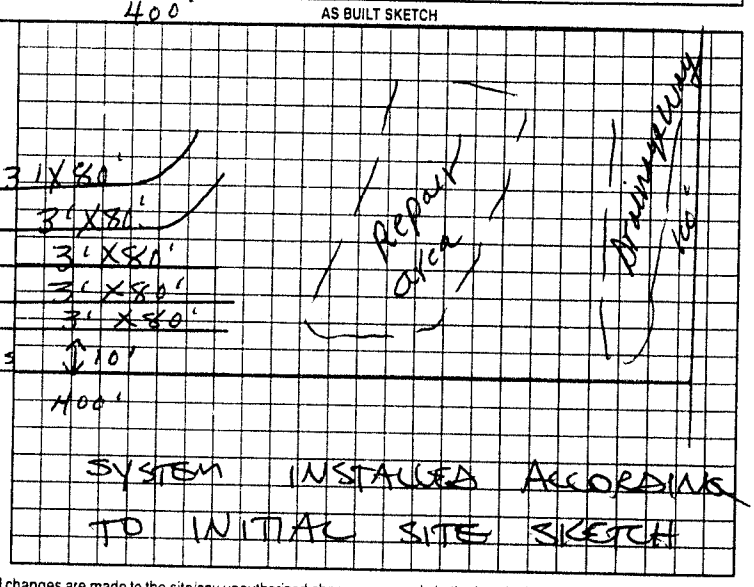

SYSTEM INSTALLED ACCORDING TO INITAL SITE SKETCH

Street

Permit can be suspended or revoked if any false information is supplied toward securing the permit/any unauthorized changes are made to the site/any unauthorized changes are made in the installation of the system. Improvement Permit with plat valid without expiration. Improvement Permit with site plan valid for sixty months. Authorization to Construct is valid for a period equal to that of Improvement Permit – not to exceed sixty months.

Signed: X [signature] date 12-7-99 Installed by: BARRY SIGMON

Improvement Permit by: P. C. Moore date 12-7-99 Operation Permit by: STEVE HENDRICK date 9-7-00

Authorization to Construct by: P. C. Moore date 12-7-99 Existing System Inspection by: date

HEALTH DEPT. COPY: WHITE OWNER COPY (FINAL): YELLOW OWNER COPY (INITIAL): PINK