# IREDELL COUNTY HEALTH DEPARTMENT

STATESVILLE 704-878-5305 MOORESVILLE 704-664-5281

## IMPROVEMENT PERMIT / CERTIFICATE OF COMPLETION / OPERATION PERMIT / EXISTING SYSTEM INSPECTION

PROPERTY DESCRIPTION NO. 16770 DATE 9-20-93 TAX MAP NO. 5J-4-A-51

OWNER OR CONTRACTOR Richard Walker PHONE: Business _____ Home 878 9624

ADDRESS Rt 15 Box 474 Sta.

LOCATION 170 E TR Bethesda TL Cornflower TR Log Cabin Loop 1/4 mi on L-Left

SUBDIVISION Five Trees Fm BLOCK / SECTION 1 LOT 67 LOT AREA 100X431 SITE CLASS. PS L.T.A.R. 1.3

Water Supply: ☑ Individual ☐ Community ☐ Public

Septic Tank: 1000 Gallons; STB 825 Date 8-11-93

Pump Tank: _____ Gallons; PT _____ Date _____

Nitrification Field: No Fields 1 Square Feet 1200 Linear Feet 400

No Lines 3 Trench Width 36 Trench Depth 18to36 Gravel Depth 12

☑ New System ☐ Repair System Type: I, II, IV, V, VI

System Description: Conv. Gravity

Repair System Description: " "

Maintenance Agreement Required: ☐ Yes ☑ No

☐ House/Mod. Home No. Bedrooms 3 Garbage Disposal: ☐ Yes ☑ No

☑ Mobile Home No. Bathrooms 2 Auto. Dishwasher: ☑ Yes ☐ No


☐ Business No. Employees _____ Auto. Washing Machine: ☑ Yes ☐ No

☐ Other _____ Other _____

☐ Slab ☑ Crawl Space ☐ Basement w/plumbing ☐ Basement wo/plumbing

Comments well Not located at time of this inspection locate at least 100' from ST System

**INITIAL SITE SKETCH**

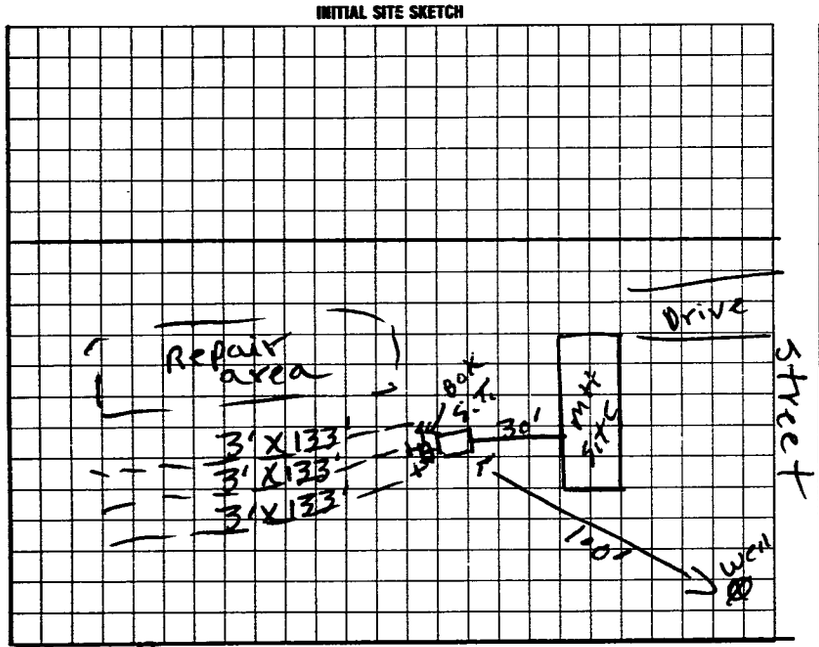


**AS BUILT SKETCH**

Same as initial sketch

I understand that this permit can be suspended or revoked if any false information is supplied toward securing the permit/any unauthorized changes are made to the site/any unauthorized changes are made in the installation of the system. Improvement Permit is valid for 60 months from date of issuance.

Signed: Richard Walker Installed by: William Cuthbertson

Improvement Permit by: L. C. Moore date 9-21-93 Certificate of Completion by: L. C. Moore date 10-5-93

Existing System Inspection by: _____ date _____ Operation Permit by: _____ date _____

HEALTH DEPT. COPY: WHITE INSPECTION COPY (FINAL): GREEN OWNER COPY (FINAL): YELLOW INSPECTION COPY (INITIAL): PINK OWNER COPY (INITIAL): GOLD