IREDELL COUNTY HEALTH DEPARTMENT

STATESVILLE 704-878-5305 MOORESVILLE 704-664-5281

IMPROVEMENT PERMIT / AUTHORIZATION TO CONSTRUCT / OPERATION PERMIT / EXISTING SYSTEM INSPECTION

PERMIT# 83953 PIN# 4762885264 DATE 9-21-99

OWNER OR CONTRACTOR Eddy Aleman PHONE: Business Home 838 0749

ADDRESS 304 Cornflower Statesville N.C.

LOCATION 70E to Bethesda TL Cornflower TR log Cabin 1st Drive left

SUBDIVISION Aleman Est. BLOCK / SECTION B LOT 2 LOT AREA 1.59 acres SITE CLASS PS DESIGN FLOW 360 L.T.A.R. .3

Septic Tank: 1000 Gallons; STB 82.5 Date 10-11-96
Pump Tank: Gallons; PT Date
Pump Make: Model Serial No.
Nitrification Field: No Fields 1 Square Feet Linear Feet
No Lines 5 Trench Width 36" Max Trench Bottom Depth 30" Gravel Depth 12"

☑ New System ☐ Repair System Type: I. II III. IV. V. VI
System Description: Conv. Gravity
Repair System Description: Gravity Chamber
Maintenance Agreement Required: ☐ Yes ☑ No

☐ Slab ☑ Crawl Space ☐ Basement w/plumbing ☐ Basement w/o plumbing

☐ House/Mod. Home ☑ Mobile Home ☐ Business ☐ Other
No. Bedrooms 3 No. Bathrooms 2 No. Employees


Water Supply: ☑ Individual ☐ Public ☐ Community

Comments/Conditions:

Comments/Conditions: Replacing 3BR Single wide with 3 BR Double wide

INITIAL SITE SKETCH

AS BUILT SKETCH

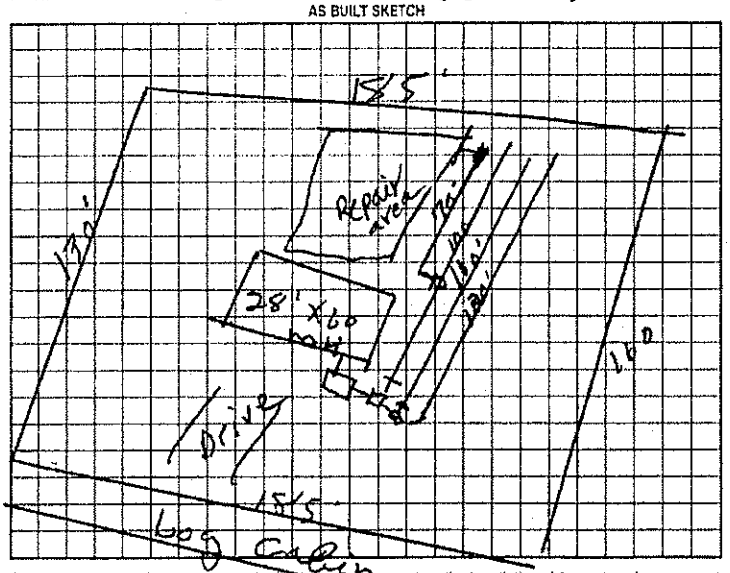

Permit can be suspended or revoked if any false information is supplied toward securing the permit/any unauthorized changes are made to the site/any unauthorized changes are made in the installation of the system. Improvement Permit with plat valid without expiration. Improvement Permit with site plan valid for sixty months. Authorization to Construct is valid for a period equal to that of Improvement Permit - not to exceed sixty months.

Signed: date Installed by: Piedmont S.T. Co

Improvement Permit by: date Operation Permit by: max ortez date 11-20-96

Authorization to Construct by: date Existing System Inspection by: P.C. Moore date 9-21-99

HEALTH DEPT COPY. WHITE OWNER COPY (FINAL) YELLOW OWNER COPY (INITIAL) PINK