Permit # 178705

Flor Aleman

Location of the proposed 40' X 50' Garage addition does not appear to impact the existing on-site septic system.**NOTE:

Justin Henderson REHS

Date: 5-15-13

ICHD-Environmental Health Division

40' to PIC

IREDELL COUNTY HEALTH DEPARTMENT

STATESVILLE 704-878-5305 MOORESVILLE 704-664-5281

IMPROVEMENT PERMIT / AUTHORIZATION TO CONSTRUCT / OPERATION PERMIT / EXISTING SYSTEM INSPECTION

PERMIT# 92792 PIN# 4762886009 DATE 1-12-00

OWNER OR CONTRACTOR Greyban Sacnz PHONE: Business Home 881 0131

ADDRESS 111 Log Cabin Rd

LOCATION 70 East TR Bethesda Rd Tb Corn Flower TR Log cabin 2nd lot left.

SUBDIVISION Aleman Est. BLOCK / SECTION LOT 1 LOT AREA .94 acres SITE CLASS. AS DESIGN FLOW 360 L.T.A.R. .3

Septic Tank: EX 1000 Gallons; ST# Date

Pump Tank: Gallons; PT Date

Pump Make: Model Serial No.

Nitrification Field: No Fields 2 Square Feet 300 Linear Feet 100

No Lines 1 Trench Width 36" Max Trench Bottom Depth 36" Gravel Depth N/A

☐ New System ☐ Repair System Type: I, II, III, IV, V, VI

System Description: Gravity 25% Reduction

Repair System Description: Gravity 25% "

Maintenance Agreement Required: ☐ Yes ☑ No

☐ House/Mod. Home ☐ Mobile Home ☐ Business ☐ Other

No. Bedrooms 3 No. Bathrooms 2 No. Employees

☐ Slab ☑ Crawl Space ☐ Basement w/plumbing ☐ Basement wo/plumbing


Water Supply: ☑ Individual ☐ Public ☐ Community

Comments/Conditions:


40'X50' Garage 25'

Comments/Conditions: This Permit Replaces one issued 7-14-99 dropping back To 3 Bedroom addition Will Take 100' of 25% Reduction System

INITIAL SITE SKETCH

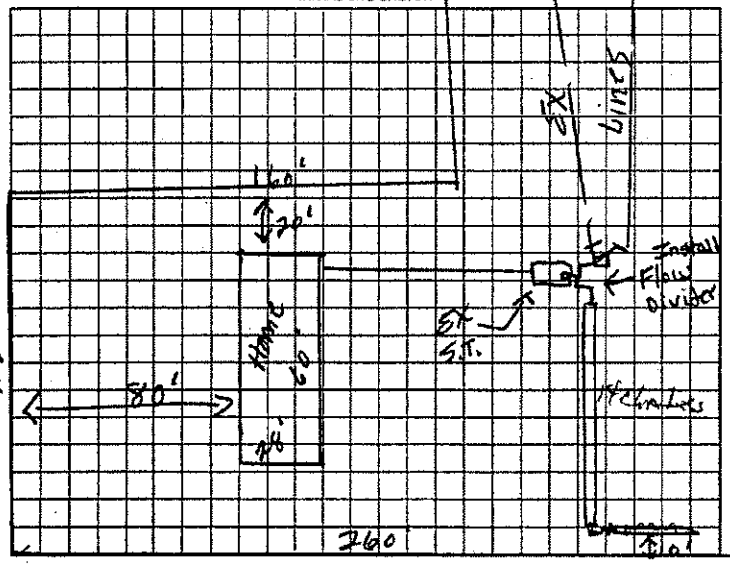

AS BUILT SKETCH

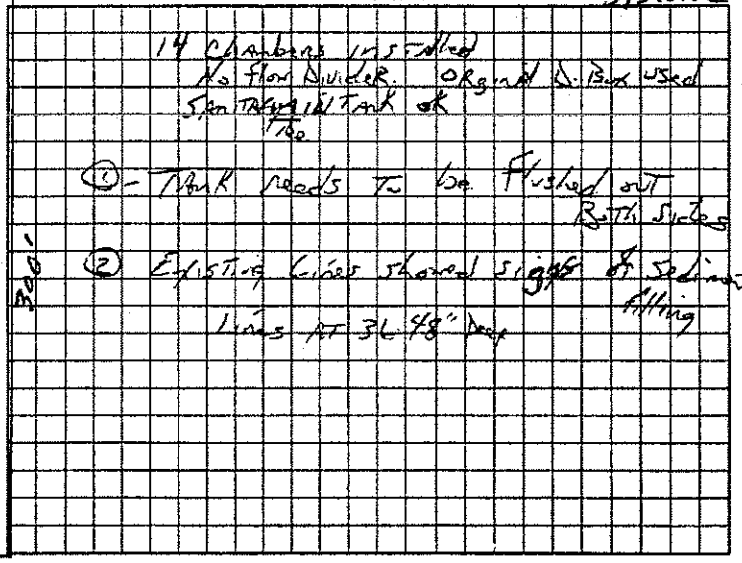

Permit can be suspended or revoked if any false information is supplied toward securing the permit/any unauthorized changes are made to the site/any unauthorized changes are made in the installation of the system. Improvement Permit with plat valid without expiration. Improvement Permit with site plan valid for sixty months. Authorization to Construct is valid for a period equal to that of Improvement Permit – not to exceed sixty months.

Signed: Georgina Aleman date

Improvement Permit by: P.C. Moore date 1-12-00

Authorization to Construct by: P.C. Moore date 1-12-00

Installed by: Bobby Bobber (Landmark Grading)

Operation Permit by: Jc Potter date June 9 Con

Existing System Inspection by: date

HEALTH DEPT. COPY: WHITE OWNER COPY (FINAL): YELLOW OWNER COPY (INITIAL): PINK