# IREDELL COUNTY HEALTH DEPARTMENT

STATESVILLE 704-878-5305 MOORESVILLE 704-664-5281

## IMPROVEMENT PERMIT / CERTIFICATE OF COMPLETION / OPERATION PERMIT / EXISTING SYSTEM INSPECTION

PROPERTY DESCRIPTION NO. 23020 DATE 2-12-96 TAX MAP NO 5J-4-A-10 Watershed Yes ✓ No

OWNER OR CONTRACTOR EDDY A. ALEMAN PHONE Business Home 838-0749

ADDRESS P.O. Box 598 STATESVILLE, NC 28677

LOCATION US 70 E, TR BETHESDA TL CORNFLOWER, TR LOG CABIN RD, 2ND LOT ON LEFT

SUBDIVISION J.L. Hope Farm BLOCK / SECTION LOT 70 LOT AREA 100 X 431 SITE CLASS DESIGN FLOW 240 LTAR EXISTING

Septic Tank: 1000 Gallons; STB Date

Pump Tank: Gallons; PT Date

Pump Make: Model Serial No

Nitrification Field: No Fields Square Feet Linear Feet 200

No Lines Trench Width Max Trench Bottom Depth Gravel Depth

New System Repair System Type (I) II III IV V

System Description CONV. GRAVITY

Repair System Description

Maintenance Agreement Required Yes ✓ No

House/Mod. Home ✓ Mobile Home Business Other

No Bedrooms 2 No Bathrooms 2 No Employees


Slab ✓ Crawl Space Basement w/plumbing Basement w/plumbing

Water Supply ✓ Individual Community Public WELL


Comments:

Comments

INITIAL SITE SKETCH

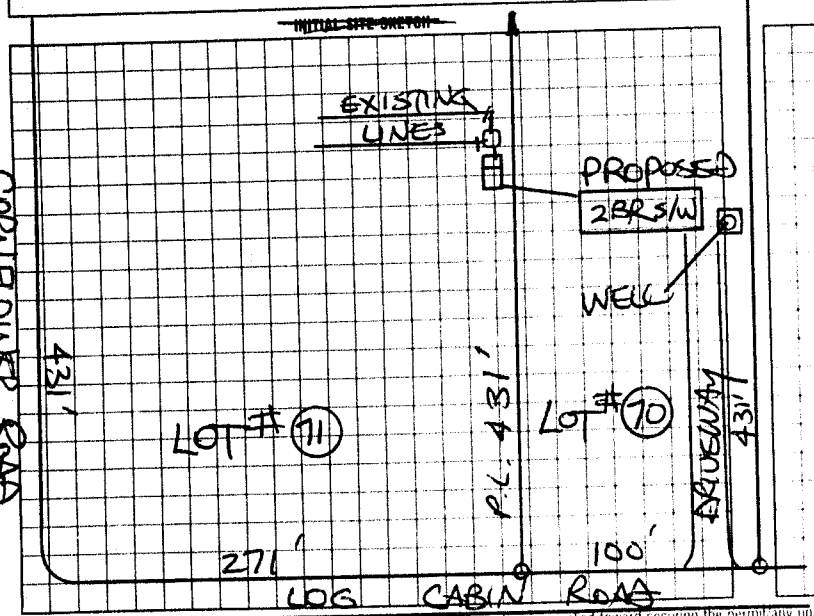


AS BUILT SKETCH

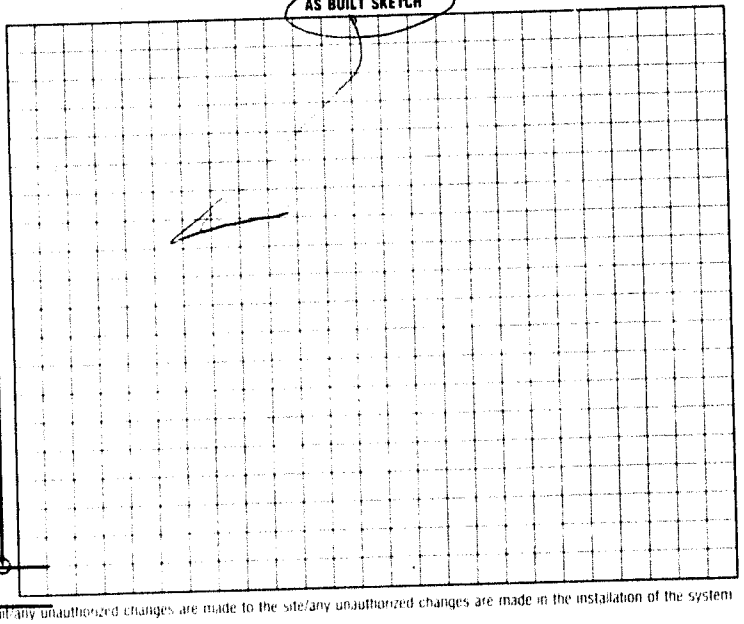

I understand that this permit can be suspended or revoked if any false information is supplied toward securing the permit any unauthorized changes are made to the site/any unauthorized changes are made in the installation of the system

Signed Installed by date

Improvement Permit by date Certificate of Completion by date

Existing System Inspection by: STEVE HENDRICK date 2-12-96 Operation Permit by date

HEALTH DEPT COPY WHITE INSPECTION COPY (FINAL) GREEN OWNER COPY (FINAL) YELLOW INSPECTION COPY (INITIAL) PINK OWNER COPY (INITIAL) GOLD