IREDELL COUNTY HEALTH DEPARTMENT

STATESVILLE 704-878-5305 MOORESVILLE 704-664-5281

IMPROVEMENT PERMIT / AUTHORIZATION TO CONSTRUCT / OPERATION PERMIT / EXISTING SYSTEM INSPECTION

PERMIT# 24811/8277 PIN# 5J-4-A-10 Tax map DATE 6-8-99

OWNER OR CONTRACTOR Eddy Aleman PHONE: Business 278-2734 Home

ADDRESS PO Box 5981 Statesville, N.C. 28677

LOCATION US 70 E TR Bethesda Road TL Cornflower ~400' on rt past log cabin Rt

SUBDIVISION Eddy Aleman BLOCK / SECTION LOT 4 LOT AREA .65 acres SITE CLASS PS DESIGN FLOW 360 L.T.A.R. .3

Septic Tank: 1000 Gallons: STB 1986 Date 9-20-99
Pump Tank: Gallons: PT Date
Pump Make: Model Serial No
Nitrification Field: No Fields 1 Square Feet 1200 Linear Feet 400
No Lines 4 Trench Width 36" Max Trench Bottom Depth 48" 30" Gravel Depth 12"

☑ New System ☐ Repair System Type: I II III IV V VI
System Description: Conv. Gravity
Repair System Description: 25% Reduction
Maintenance Agreement Required: ☐ Yes ☑ No

☑ House/Mod. Home No. Bedrooms 3
☐ Mobile Home No. Bathrooms 2
☐ Business No. Employees
☐ Other


☐ Slab ☑ Crawl Space ☐ Basement w/plumbing ☐ Basement wo/plumbing

Water Supply: ☑ Individual ☐ Public ☐ Community Well


Comments/Conditions: Replaces Permit
Issued 9-7-96

Comments/Conditions:

INITIAL SITE SKETCH

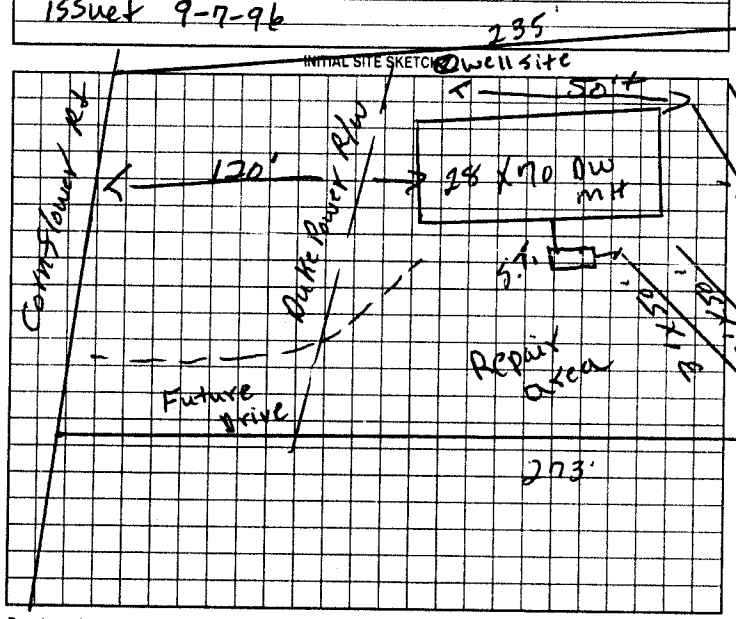

AS BUILT SKETCH

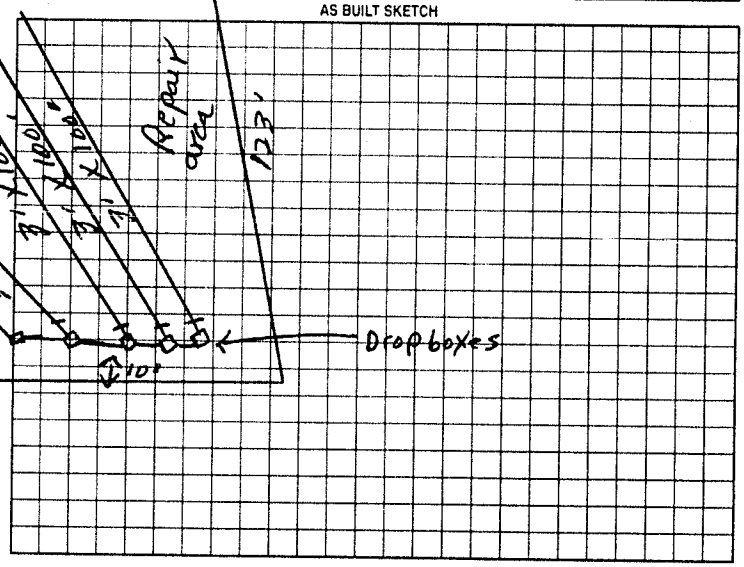

Permit can be suspended or revoked if any false information is supplied toward securing the permit/any unauthorized changes are made to the site/any unauthorized changes are made in the installation of the system. Improvement Permit with plat valid without expiration. Improvement Permit with site plan valid for sixty months. Authorization to Construct is valid for a period equal to that of Improvement Permit – not to exceed sixty months.

Signed: Eddy Aleman date 6-10-99 Installed by: Kranupp Grading

Improvement Permit by: P. C. Moore date 6-8-99 Operation Permit by: P. C. Moore date 1-12-00

Authorization to Construct by: P. C. Moore date 6-8-99 Existing System Inspection by: date

HEALTH DEPT. COPY: WHITE OWNER COPY (FINAL): YELLOW OWNER COPY (INITIAL): PINK