IREDELL COUNTY HEALTH DEPARTMENT

Statesville Office (704) 878-5305 Mooresville Office (704) 660-3625 PERMIT # 215 7/16

IMPROVEMENT PERMIT / AUTHORIZATION TO CONSTRUCT / OPERATION PERMIT / EXISTING SYSTEM

PIN # 4763-03-9309.000 V

APPLICANT: Rollans Soil & Environmental APPLICANT ADDRESS: 470 N. Broad St. Suite D Mooresville NC.

SITE ADDRESS: 168 Wayside Rd. Statesville NC 28677 PHONE: 704-746-5046 ALT. PHONE: 704-402-6152

SITE DIRECTIONS: Hwy 70 E. TR Nabors Rd., TR Wayside Rd. Site on R

SUBDIVISION: — SECTION: — LOT # — LOT AREA: .546 Acre DESIGN FLOW: Ex. 360 GPD L.T.A.R.: .3 Ex. / .3 R

Septic Tank Existing (gal) STB Date
Pump Tank (gal) PT Date
Pump Make Model Serial #
Nitrification Fields Ex. # Lines Ex 5 Linear Ft: Ex.
Trench Width Ex. Max. Trench Bottom Depth Ex. Gravel Depth Ex.

☐ New System ☐ Repair ☐ Expansion System Type: I ☒ II III IV V VI
System Description: Existing Conventional - Gravity
Repair System Description: LS - AMBAS
Maintenance Agreement Required: ☐ YES ☒ NO
☒ GRAVITY ☐ PRESSURE

☒ Residence ☐ Business ☐ Other ☐ Slab ☐ Basement w/plumbing
No. Bedrooms Ex. 3 No. Persons Ex. 6 No. Employees — ☒ Crawl Space ☐ Basement w/o plumbing

Water Supply: ☒ Private ☐ Public ☐ Community

Comments / Conditions: Existing System Recorded To Be Functioning @ Time Of Inspection.
- Maintain 5' From Septic w/ Any Building Structure.
- No Foundation Drain To Be Used For New Mobile Home.
- Maintain 25' From Label w/ Structure.

INITIAL SITE SKETCH

See Attached / Approved Site Plan By Rollans Soil & Environmental Services

Dated APPROVED FEB 12 2016

AS BUILT SKETCH

Purpose of This Permit Is To Relocate Repair As Part of Property Has Changed Ownership.
Original OP Signed 6/5/96

Owner/Applicant Rollans
Paid Cash 2/17/16
FHS SC
Amount Owed $ 300.00
Ex. → Repair Reco.

Permit can be suspended or revoked if any false information is supplied toward securing the permit / any unauthorized changes are made to the site / any unauthorized changes are made in the installation of the system. **CONTACT A LOCATOR SERVICE PRIOR TO ANY EXCAVATION**

☐ **IMPROVEMENT PERMIT** *with plat valid without expiration* ☐ **IMPROVEMENT PERMIT** *with site plan valid for 60 mos.* ☐ **AUTHORIZATION TO CONSTRUCT** *valid for period equal to IMPROVEMENT PERMIT--not to exceed 60 mo.*

Owner / Applicant Signature: Date: 2/25/16 Installed by: H-Backhoe

IMPROVEMENT PERMIT by: Date: 2/12/16 OPERATION PERMIT by: Date: 2/12/16


AUTHORIZATION TO CONSTRUCT by: Date: 2/12/16 Existing System Inspected by: APPROVED FEB 12 2016

Health Dept. Copy - WHITE Applicant (Final Approval) - YELLOW Applicant (Conditional Approval) - PINK

Scale 1" = 50'

106 ft

OBDULIA TORRES

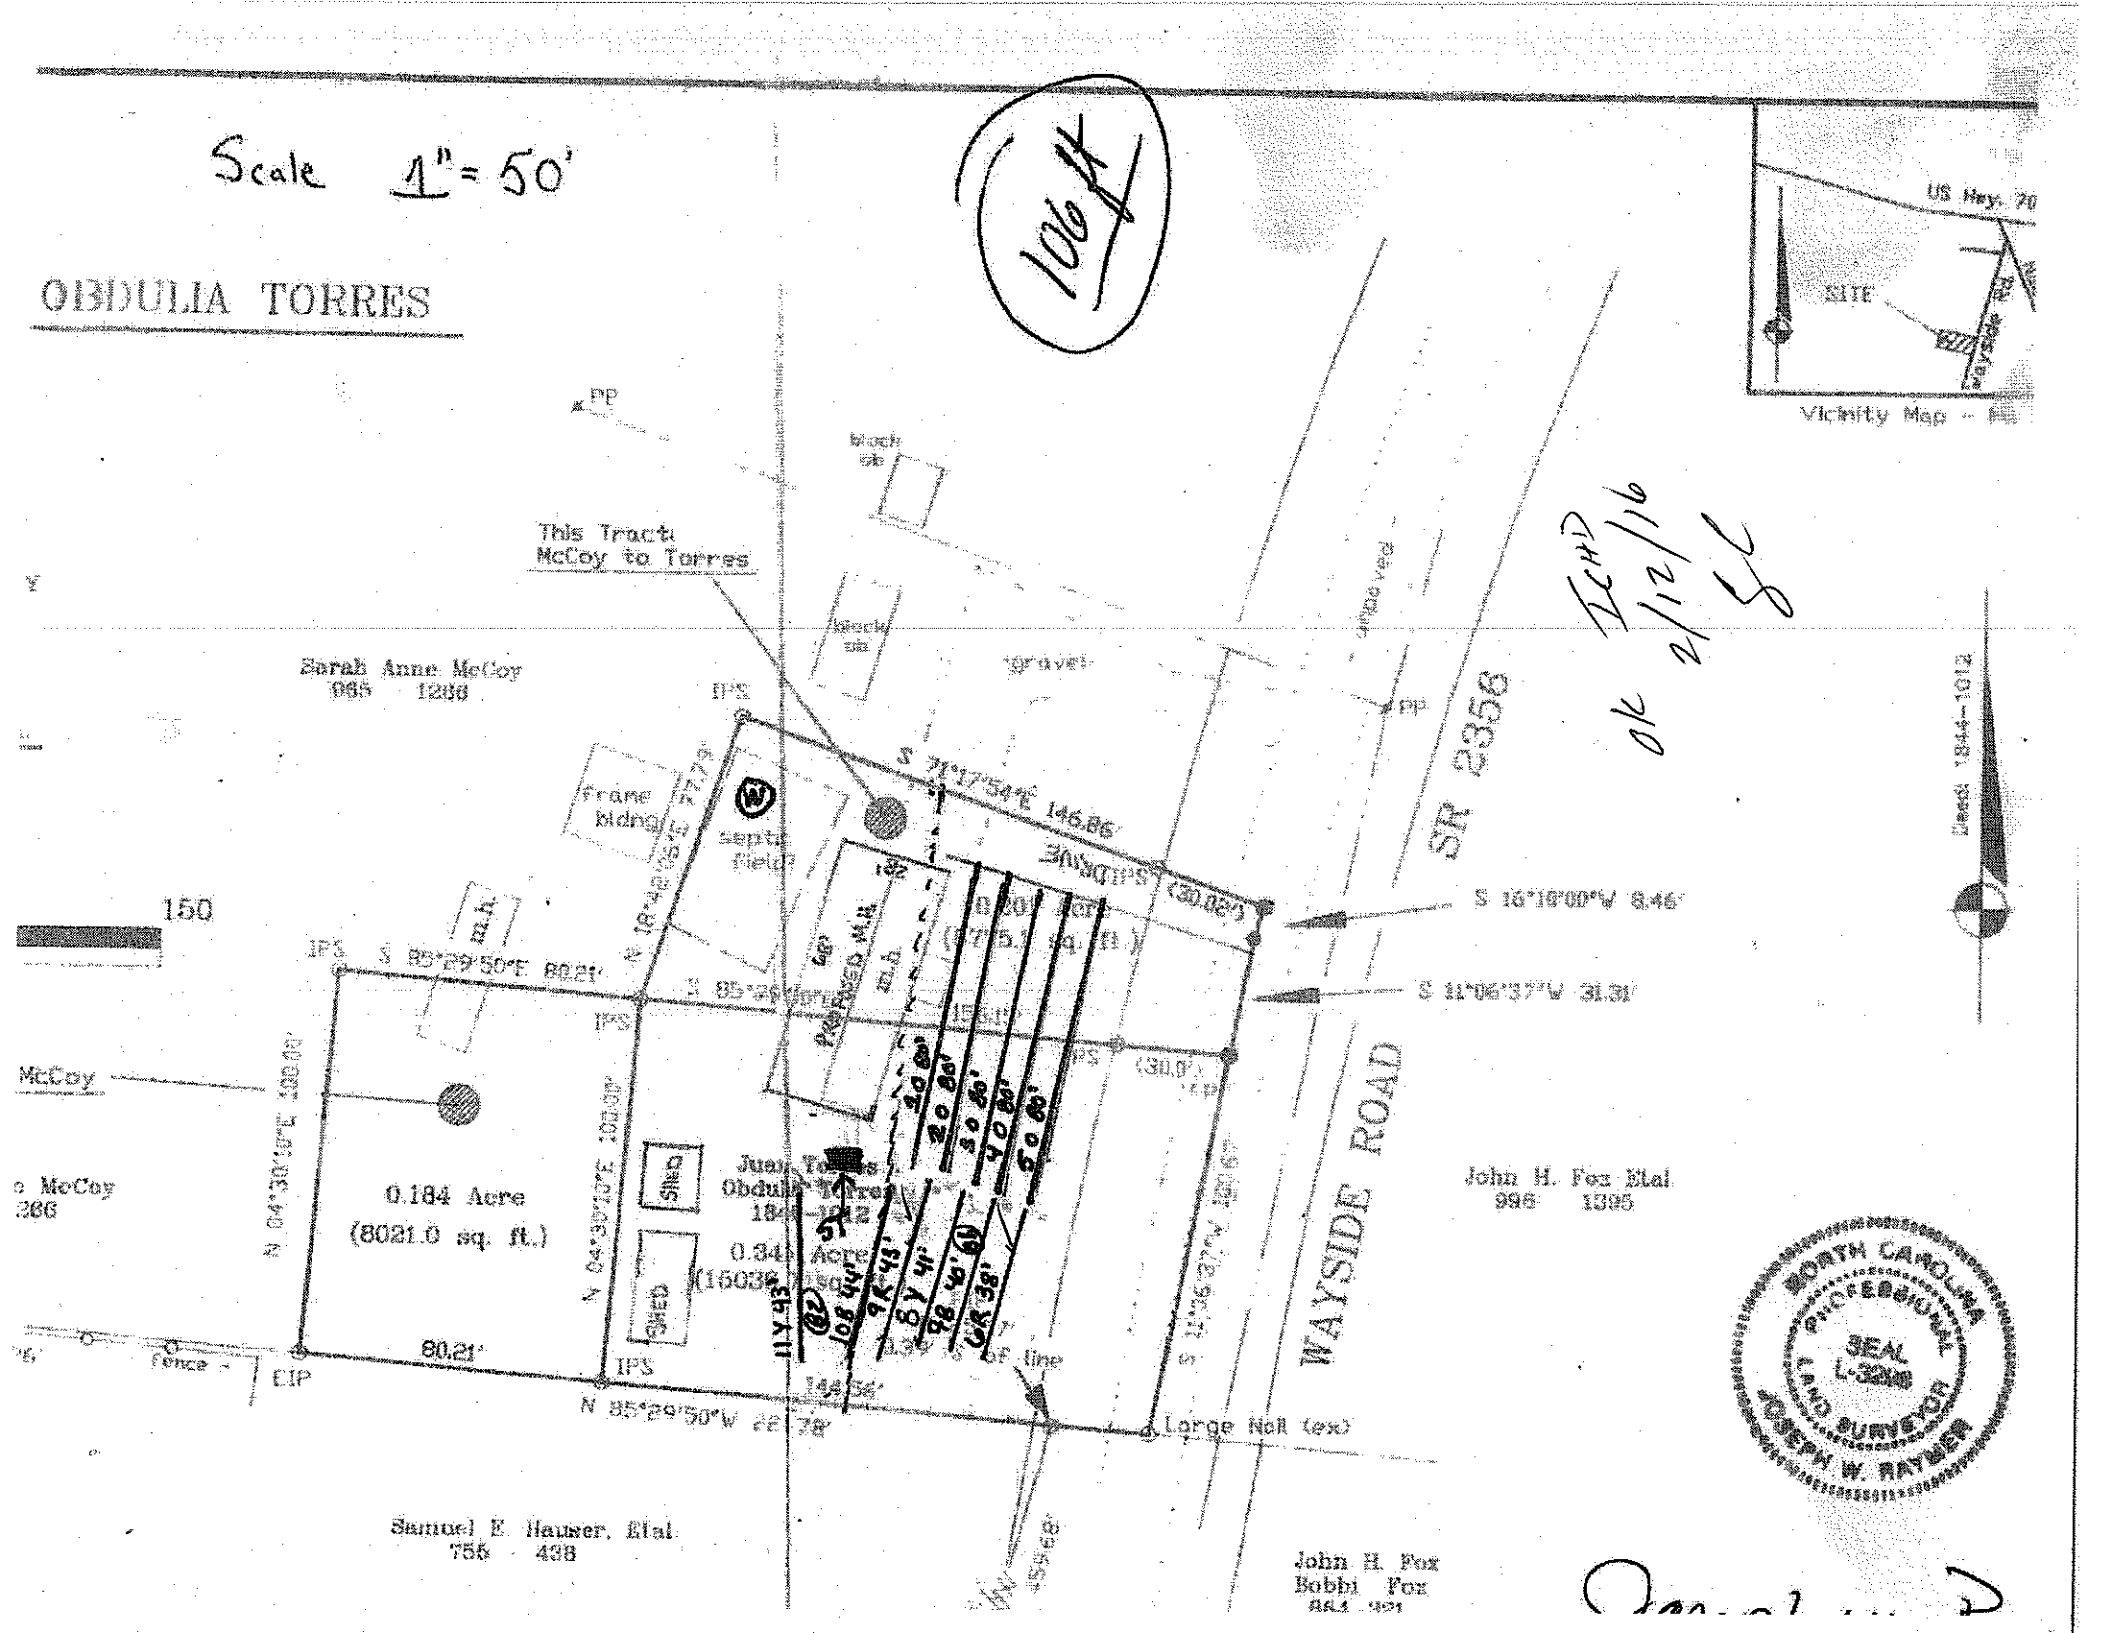

Deed
OK
2/12/16