IREDELL COUNTY HEALTH DEPARTMENT

STATESVILLE 704-878-5305 MOORESVILLE 704-664-5281

61379 4:30

IMPROVEMENT PERMIT / CERTIFICATE OF COMPLETION / OPERATION PERMIT / EXISTING SYSTEM INSPECTION

PROPERTY DESCRIPTION NO. 23637 DATE 5-31-96 TAX MAP NO. 5M-A-68

OWNER OR CONTRACTOR Tim McCoy PHONE: Business Home 873 1481 Watershed: ☐ Yes ☐ No

ADDRESS 2016 Northside Drive

LOCATION 70E TR Nabors RD TR Wayne 3rd lot Rt

SUBDIVISION BLOCK / SECTION LOT LOT AREA .529 acres SITE CLASS. PS DESIGN FLOW 360 L.T.A.R. 1.3

Septic Tank: 1000 Gallons; STB 744 Date 3-14-94

Pump Tank: Gallons; PT Date

Pump Make: Model Serial No.

Nitrification Field: No Fields 1 Square Feet 1200 Linear Feet 400

No Lines 5 Trench Width 36" Max Trench Bottom Depth 36" Gravel Depth 12"

☑ New System ☐ Repair System Type: I / II / III / IV / V / VI

System Description: Conventional

Repair System Description: " "

Maintenance Agreement Required: ☐ Yes ☑ No

☐ House/Mod. Home ☑ Mobile Home ☐ Business ☐ Other

No. Bedrooms 3 No. Bathrooms 2 No. Employees


☐ Slab ☑ Crawl Space ☐ Basement w/plumbing ☐ Basement wo/plumbing

Water Supply: ☑ Individual ☐ Community ☐ Public


Comments:

Comments:

INITIAL SITE SKETCH

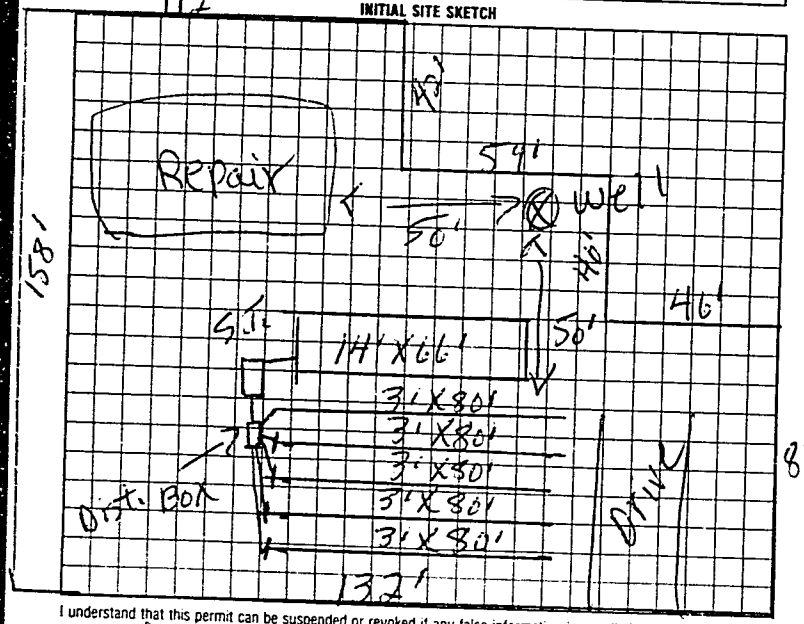

AS BUILT SKETCH

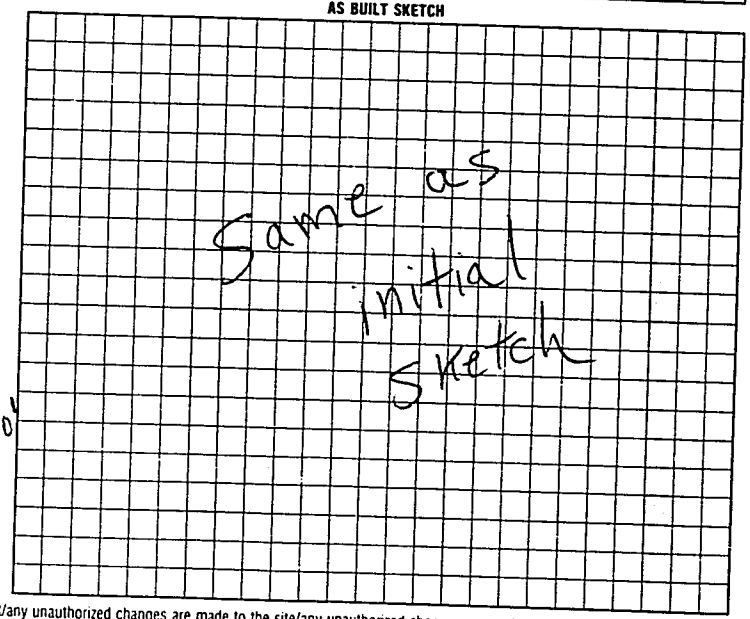

I understand that this permit can be suspended or revoked if any false information is supplied toward securing the permit/any unauthorized changes are made to the site/any unauthorized changes are made in the installation of the system.

Signed: Tim Hall

Improvement Permit by: L.C. Moore date 5-31-96

Authorization to Count Existing System Inspection by: L.C. Moore date 5-31-96

HEALTH DEPT COPY WHITE INSPECTION COPY (INITIAL) GREEN OWNER COPY (FINAL) YELLOW

Authorization to Count. Expires 6-5-96 Moz St. m issue

Installed by: A-1 Backhoe

Certificate of Completion by: date

Operation Permit by L.C. Moore date 6-5-96

INSPECTION COPY (INITIAL) PINK OWNER COPY (INITIAL) GOLD