IREDELL COUNTY HEALTH DEPARTMENT

STATESVILLE 704-878-5305 MOORESVILLE 704-664-5281

6411 2

IMPROVEMENT PERMIT / CERTIFICATE OF COMPLETION / OPERATION PERMIT / EXISTING SYSTEM INSPECTION

PROPERTY DESCRIPTION NO. 25020 DATE 9-25-96 TAX MAP NO. 5m-A-69 Watershed: ☐ Yes ☐ No

OWNER OR CONTRACTOR Halybrook Properties PHONE: Business 528-6552 Home

ADDRESS 313 Pilch Rd Troutman

LOCATION 70E TR Old Warren Dr. at end on left

SUBDIVISION BLOCK / SECTION LOT LOT AREA 2.51 acres SITE CLASS. 6ps DESIGN FLOW 360 L.T.A.R. .3

Septic Tank: 1000 Gallons; STB 1012 Date 8-1-96

Pump Tank: Gallons; PT Date

Pump Make: Model Serial No.

Nitrification Field: No Fields 1 Square Feet 1200 Linear Feet 400

No Lines 3 Trench Width 36" Max Trench Bottom Depth 34" Gravel Depth 12"

☑ New System ☐ Repair System Type: I, II, III, IV, V, VI

System Description: Conv. Gravity

Repair System Description:

Maintenance Agreement Required: ☐ Yes ☑ No

☐ House/Mod. Home No. Bedrooms 3

☑ Mobile Home No. Bathrooms 2

☐ Business No. Employees

☐ Other


☐ Slab ☑ Crawl Space ☐ Basement w/plumbing ☐ Basement wo/plumbing

Water Supply: ☑ Individual ☐ Community ☐ Public


Comments:

Comments:

INITIAL SITE SKETCH

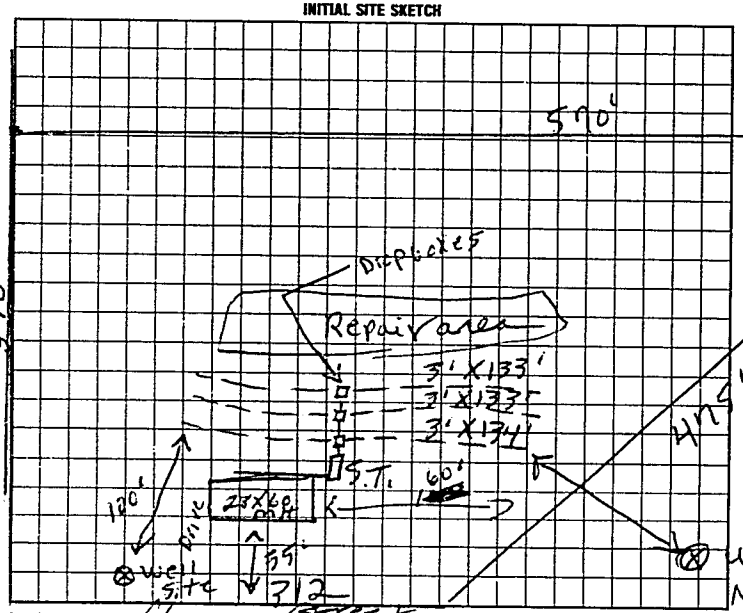

AS BUILT SKETCH

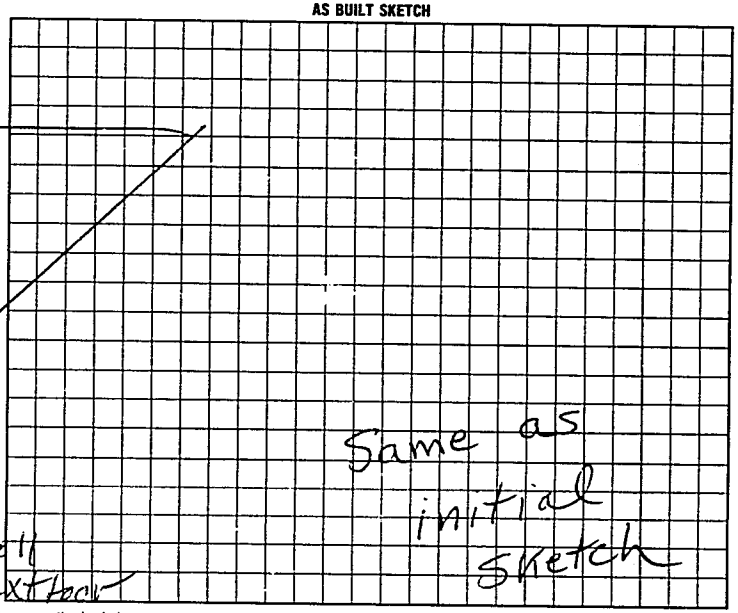

I understand that this permit can be suspended or revoked if any false information is supplied toward securing the permit/any unauthorized changes are made to the site/any unauthorized changes are made in the installation of the system.

Signed: X Allen C. Riddle for Halybrook Partnership

Improvement Permit by: P.C. moore date 9-25-96

Existing System Inspection by: P.C. moore date 9-25-96

Installed by: Donald Lackey

Certificate of Completion by: date

Operation Permit by: P.C. moore date 11-14-96

to county dept. COPY WHITE INSPECTION COPY (FINAL): GREEN OWNER COPY (FINAL): YELLOW INSPECTION COPY (INITIAL): PINK OWNER COPY (INITIAL): GOLD

* Authorization to count EXPIRES 60 mos from issue

L 5000