IREDELL COUNTY HEALTH DEPARTMENT

STATESVILLE 704-878-5305 MOORESVILLE 704-664-5281

IMPROVEMENT PERMIT / AUTHORIZATION TO CONSTRUCT / OPERATION PERMIT / EXISTING SYSTEM INSPECTION

PERMIT # 166186 PIN # 4763 19 4689 DATE May 23, 2011

OWNER or APPLICANT Eric + Amy Lambert PHONE: Business Applicant # 704 902 0429 Home:

OWNER or APPLICANT ADDRESS 257 Fanjoy Rd.

LOCATION / DIRECTIONS Hwy 70 East to TL Fanjoy Rd. .9 mile on Right (past jct w/ Twin Oaks Rd.) #336

SUBDIVISION BLOCK / SECTION LOT # LOT AREA 22.771ac DESIGN FLOW 360 gpd L.T.A.R. .25 suitable/.3 repair area

Septic Tank 1000 Gallons: STB 1012 Date 7-26-11

Pump Tank Gallons: P T Date

Pump Make Model Serial #

Nitrification Field No Fields 1 No Lines 4 Linear Feet 480

Trench Width 36" Max. Trench Bottom Depth 36" Gravel Depth 12"

☒ New System ☐ Repair ☐ Expansion System Type I (II) III IV V VI

System Description: Gravity conventional or Accepted

Repair System Description: Pumped conventional or accepted

Maintenance Agreement Required ☐ YES ☒ NO

☒ GRAVITY ☐ PRESSURE

☒ Residence No. Bedrooms 3

☐ Business No. Persons

☐ Other No. Employees

☐ Slab ☒ Crawl Space


☐ Basement w/plumbing ☐ Basement w/o plumbing

Water Supply: ☒ Private Existing ☐ Public ☐ Community


Comments / Conditions: 360 linear feet of accepted (25% reduction) trenches may be used.

Comments / Conditions

INITIAL SITE SKETCH

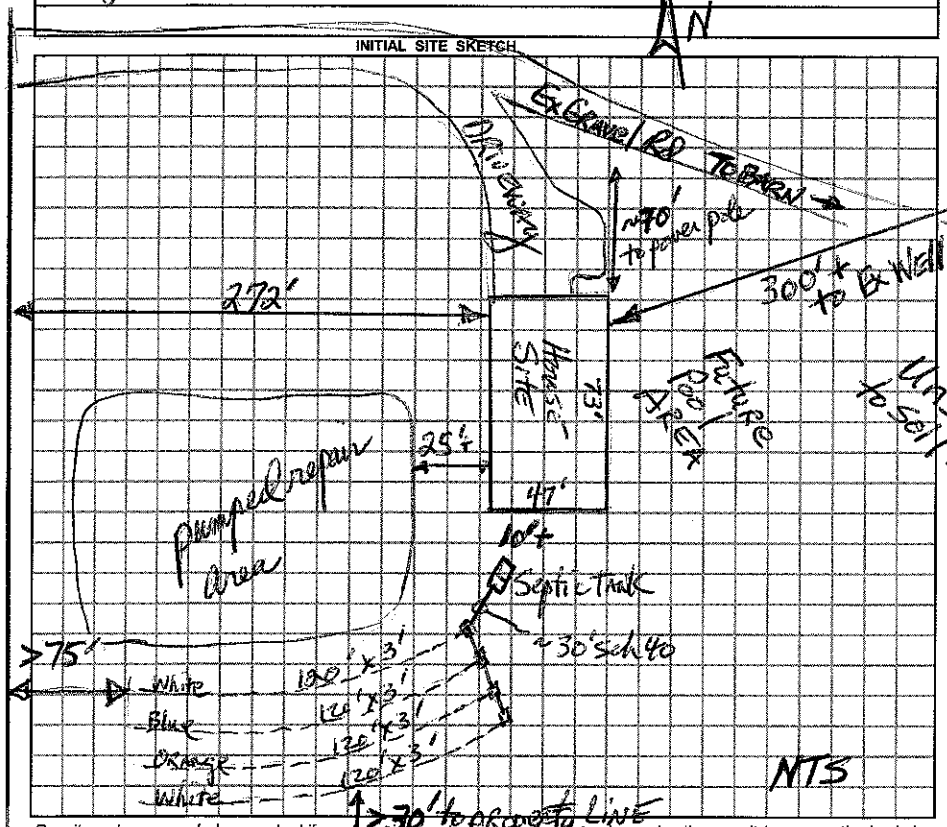

AS BUILT SKETCH

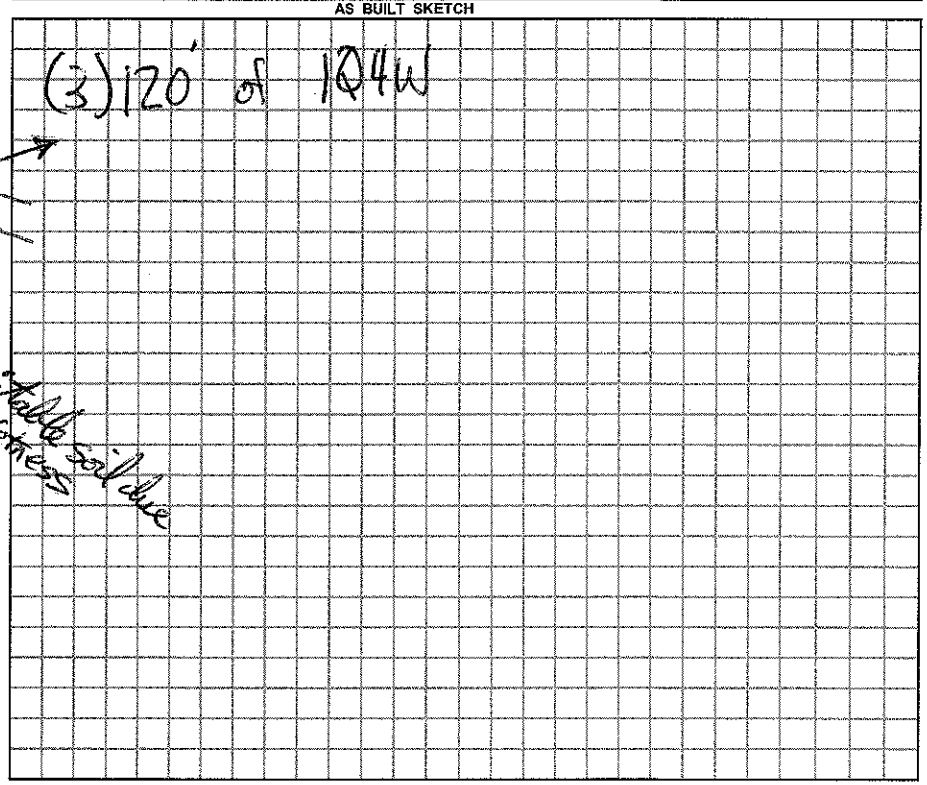

Permit can be suspended or revoked if any false information is supplied toward securing the permit / any unauthorized changes are made to the site / any unauthorized changes are made in the installation of the system.

☐ IMPROVEMENT PERMIT w / plat valid without expiration. ☒ IMPROVEMENT PERMIT w / site plan valid for 60 mos. ☒ AUTHORIZATION TO CONSTRUCT valid for period equal to IMPROVEMENT PERMIT-not to exceed 60 mo.

Owner / Applicant Signature: Date 5-27-11

Improvement Permit by: Date 5-23-11

Authorization to Construct by: Date 5-23-11

Installed by: Madison Grading

Operation Permit by: Date: 11-1-11

Existing System Inspected by: Date:

YOU SHOULD CONTACT A LOCATOR SERVICE PRIOR TO ANY EXCAVATION.

WHITE COPY Environmental Health YELLOW COPY (Final) Owner / Applicant PINK COPY (Initial) Owner / Applicant