IREDELL COUNTY HEALTH DEPARTMENT

STATESVILLE 704-878-5305 MOORESVILLE 704-664-5281

IMPROVEMENT PERMIT / AUTHORIZATION TO CONSTRUCT / OPERATION PERMIT / EXISTING SYSTEM INSPECTION

PERMIT# 98005 PIN# 4763 12 5708 DATE 3-15-00

OWNER OR CONTRACTOR John Carey Fox PHONE: Business Home 528 5724

ADDRESS PO BOX 582 Trbutman N.C. 28166

LOCATION Salisbury Rd TR Nabors, 2 mile on Rt.

SUBDIVISION BLOCK / SECTION LOT LOT AREA 1.8 Acres SITE CLASS PS DESIGN FLOW 360 L.T.A.R. .3 gal/sq'/day

Septic Tank: 1000 Gallons; STB 1012 Tp Date 1-21-00
Pump Tank: Gallons; PT Date
Pump Make: Model Serial No.
Nitrification Field: No Fields 1 Square Feet 1200 Linear Feet 400
No Lines 4 Trench Width 36" Max Trench Bottom Depth 36" Gravel Depth 12"

☑ New System ☐ Repair System Type: I. II. III. IV. V. VI
System Description: Conv. Gravity
Repair System Description:
Maintenance Agreement Required: ☐ Yes ☐ No


☐ House/Mod. Home No. Bedrooms 3
☐ Mobile Home No. Bathrooms 2
☐ Business No. Employees
☐ Other
☐ Slab ☑ Crawl Space ☐ Basement w/plumbing ☐ Basement wo/plumbing

Water Supply:
☑ Individual
☐ Public
☐ Community
Well Next Door


Comments/Conditions: Well drilled where Shown a Repair Need to be INNOVATIVE -25% Reduction

Comments/Conditions: Well drilled Here

INITIAL SITE SKETCH 220'

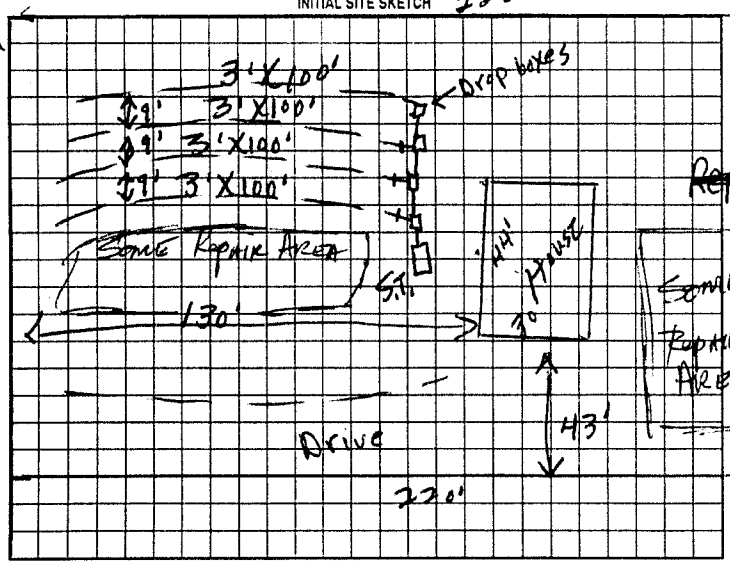

AS BUILT SKETCH

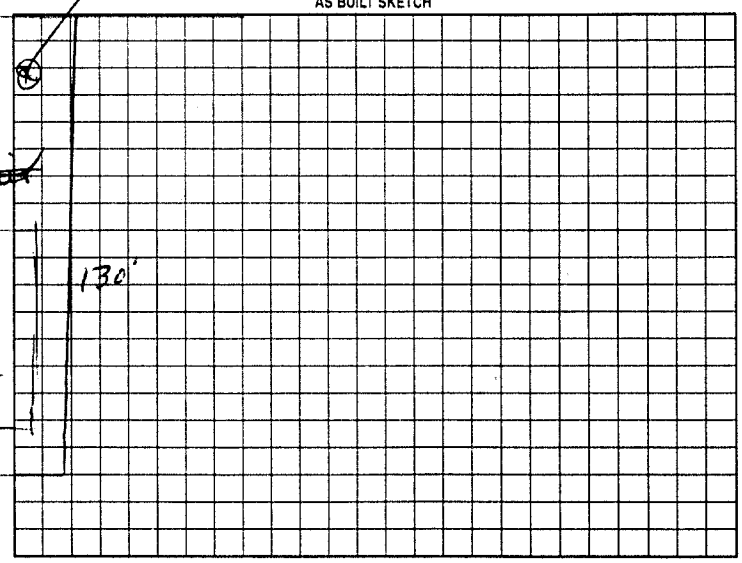

Permit can be suspended or revoked if any false information is supplied toward securing the permit/any unauthorized changes are made to the site/any unauthorized changes are made in the installation of the system. Improvement Permit with plat valid without expiration. Improvement Permit with site plan valid for sixty months. Authorization to Construct is valid for a period equal to that of Improvement Permit – not to exceed sixty months.

Signed: date 3-23-00 Installed by: Steve Jordan

Improvement Permit by: P. C. Moore date 3-15-00 Operation Permit by: date 6-1-00

Authorization to Construct by: P. C. Moore date 3-15-00 Existing System Inspection by: date

HEALTH DEPT. COPY: WHITE OWNER COPY (FINAL): YELLOW OWNER COPY (INITIAL): PINK